

WASH.
E 85
7-13-73

MISSISSIPPI
BOARD OF WATER COMMISSIONERS
416 North State Street
Jackson, Mississippi 39201

CODED

WATER WELL DRILLERS LOG

DYER WELL & IRRIGATION SERVICE WASHINGTON

7-13 1973 date well completed firm name county well located

LANDOWNER: ~~ALLEN BLINKSCALE~~

description of formations encountered from to

WARREN HAMMETT

CLAY	0	33
FINE SAND	33	43
SAND GRAVEL	43	92

GREENVILLE, Miss.

(mailing address)

WELL LOCATION:

sec. 20 T 18 N R 7 E
W
2 1/2 miles W of LELAND
(distance) (direction) (nearest town)

WELL PURPOSE: IRRIGATION
(home, irrigation, municipal, industrial)

WELL COMPLETION DATA:

- (1) diameter (inches) 16"
- (2) total depth (feet) 92'
- (3) static water level (feet) 22' below top of ground.
- (4) casing BLK IR 52' (material), (depth)
16" (size) if telescope see back.
- (5) screen 40' 52' (length), (depth to top)
16" BLK IN GOT (size), (material)
- (6) pump 50 1200 (HP), (yield gpm)
Dieser (type power)
- (7) electric log No (yes or no)

CODED

(organization running log)

(8) how well bottom plugged PLATE


OCT 25 1973

DRILLERS REMARKS:

MISS. DEP. OF
WATER RESOURCES
JACKSON, MISSISSIPPI

If well telescopes please sketch and show depths.

GROUND LEVEL

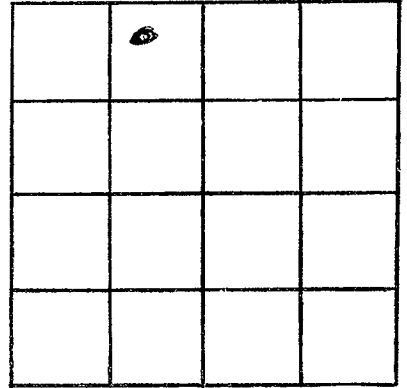

SECTION 20

Please indicate well location X.

ADDITIONAL INFORMATION

If more than one screen,
show locations of each on sketch.