

**WASHINGTON**  
**E 86**  
**3-22-77**

MISSISSIPPI  
 BOARD OF WATER COMMISSIONERS  
 416 North State Street  
 Jackson, Mississippi 39201

WATER WELL DRILLERS LOG


3-22 1977 74 Schultz Drilling Co Washington  
 date well completed firm name county well located

LANDOWNER:	description of formations encountered	from	to
<u>Mosow Eng</u>			
<u>P.O. Box 1099</u>	<u>Clay</u>	<u>0</u>	<u>22</u>
<u>GREENVILLE, Miss</u> (mailing address)	<u>Sand</u>	<u>22</u>	<u>87</u>
WELL LOCATION: sec. <u>17</u> T. <u>18</u> N R. <u>7</u> W	<u>Sandy shales</u>	<u>87</u>	<u>900</u>
<u>3</u> miles <u>W</u> of <u>Leland</u>	<u>Sand shale</u>		
(distance) (direction) (nearest town)	<u>Sand</u>	<u>400</u>	<u>490</u>
WELL PURPOSE: (home, irrigation, municipal, industrial)			
WELL COMPLETION DATA:			
(1) diameter (inches) <u>6 X 4</u>			
(2) total depth (feet) <u>490</u>			
(3) static water level (feet) <u>48</u> below top of ground.			
(4) casing <u>Black steel</u> (material) (depth)			
(size) If telescope see back.			
(5) screen <u>25</u> (length) (depth to top)			
<u>4"</u> <u>Stainless</u> (size) (material)			
(6) pump <u>15</u> <u>250</u> (HP) (yield gpm)			
<u>3 hp</u> (type power)			
(7) electric log <u>NO</u> (yes or no)			
(organization running log)			
(8) how well bottom plugged <u>Spurk</u>			
DRILLERS REMARKS:			

**CODED**  
**TRAILER PARK**

If well telescopes please sketch and show depths.

GROUND LEVEL

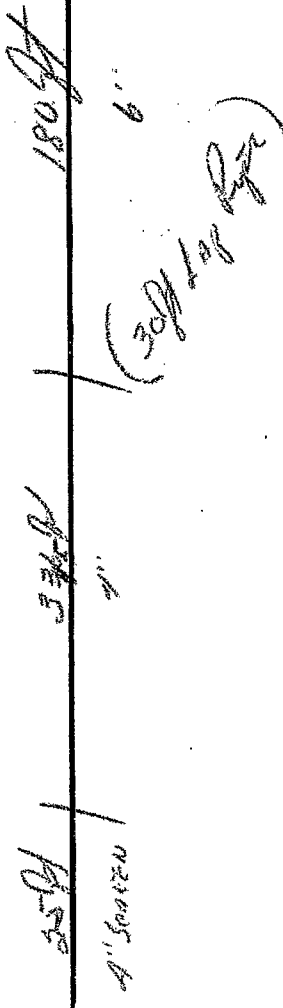

X			

SECTION 17

Please indicate well location X.

ADDITIONAL INFORMATION

Multiple horizontal lines for additional information.

If more than one screen, show locations of each on sketch.