


WASHINGTON  
E 88  
3-8-74

MISSISSIPPI  
BOARD OF WATER COMMISSIONERS  
416 North State Street  
Jackson, Mississippi 39201

CODED

WATER WELL DRILLERS LOG

March 8, 1974 Singer-Layne Central Div. Washington  
date well completed firm name county well located

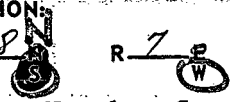
LANDOWNER:	description of formations encountered	from	to
Camellia Farms, Inc. Stoneville, Mississippi (mailing address)	Clay	0	20
	Fine Sand	20	40
	Sand & Pea Gravel	40	55
	Coarse Sand	55	90
	Rock & Sand	90	107
<b>WELL LOCATION:</b> sec. <u>9</u> T. <u>18</u> N. R. <u>7</u> W.  _____ miles North of Stoneville (distance) (direction) (nearest town)			
<b>WELL PURPOSE:</b> Irrigation (home, irrigation, municipal, industrial)			
<b>WELL COMPLETION DATA:</b>			
(1) diameter (inches) <u>16"</u>			
(2) total depth (feet) <u>107'</u>			
(3) static water level (feet) <u>14</u> below top of ground.			
(4) casing <u>Steel</u> , <u>57'</u> (material) (depth) <u>16"</u> If telescope see back. (size)			
(5) screen <u>50'</u> , <u>107'</u> (length) (depth to top) <u>16"</u> , <u>Armco Iron</u> (size) (material)			
(6) pump <u>60</u> , <u>2800</u> (HP) (yield gpm) <u>Engine</u> (type power)			
(7) electric log <u>No</u> (yes or no)			
(organization running log)			
(8) how well bottom plugged <u>Plate</u>			
DRILLERS REMARKS:			

CODED

MISSISSIPPI  
BOARD OF WATER COMMISSIONERS  
APR 24 1974  
MISS. BR. OF WATER COMMISSIONERS

If well telescopes please sketch and show depths.

GROUND LEVEL

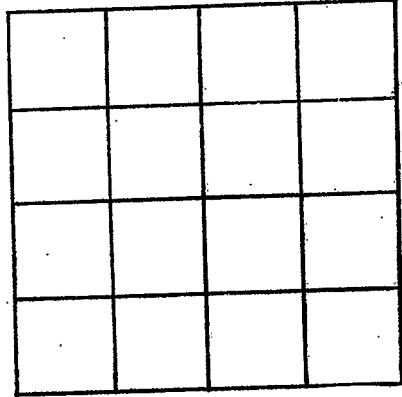

SECTION \_\_\_\_\_

Please indicate well location X.

ADDITIONAL INFORMATION

If more than one screen, show locations of each on sketch.