

WASH.
E 89
1-23-75

MISSISSIPPI
BOARD OF WATER COMMISSIONERS
416 North State Street
Jackson, Mississippi 39201

CODED

WATER WELL DRILLERS LOG

January 23, 1975 Singer-Layne Central Div. Washington
date well completed firm name county well located

LANDOWNER:	description of formations encountered	from	to
Camellia Farms			
P. O. Box 8			
Stoneville, MS 38776 (mailing address)	Clay	0	22
	Fine Sand	24	45
	Coarse Sand	45	57
	Coarse Sand Gravel	57	80
	Gravel & Boulders	80	90
	Sand & Gravel	90	111
	Clay	111	112
WELL LOCATION:			
sec. 4 T 18 N R 7 E X W			
3 miles northwest Stoneville (distance) (direction) (nearest town)			
WELL PURPOSE: irrigation (home, irrigation, municipal, industrial)			
WELL COMPLETION DATA:			
(1) diameter (inches) 16"			
(2) total depth (feet) 112'			
(3) static water level (feet) 15' below top of ground.			
(4) casing steel 62' (material) (depth)			
16" (size) if telescope see back.			
(5) screen 50' 62' (length) (depth to top)			
16" (size) steel (material)			
(6) pump 60 2800-3000 (HP) (yield gpm)			
engine (type power)			
(7) electric log No (yes or no)			
(organization running log)			
(8) how well bottom plugged with plate			
DRILLERS REMARKS:			


CODED

RECEIVED
JAN 27 1975

MISS. BD OF WATER COMMISSIONERS

If well telescopes please
sketch and show depths.

GROUND LEVEL

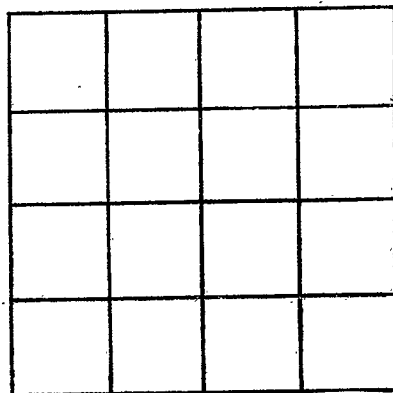

SECTION _____

Please indicate well location X.

ADDITIONAL INFORMATION

If more than one screen,
show locations of each on sketch.