

WASH.
E 90
2-10-75

MISSISSIPPI
BOARD OF WATER COMMISSIONERS
416 North State Street
Jackson, Mississippi 39201
WATER WELL DRILLERS LOG

CODED

February 10 19 75 Singer-Layne Central Div. Washington
date well completed firm name county well located

LANDOWNER: Camellia Farms, Inc. P. O. Box 8 Stoneville, MS 38776 (mailing address)	description of formations encountered	from	to
WELL LOCATION: sec. <u>4</u> T <u>18</u> N R <u>7</u> W 2 miles north of Stoneville (distance) (direction) (nearest town)	Top Soil	0	12
	Silt	12	40
	Fine Sand	40	52
	Coarse Sand	52	60
	Gravel & Sand	60	105
	Rock		105
WELL PURPOSE: irrigation (home, irrigation, municipal, industrial)			
WELL COMPLETION DATA: (1) diameter (inches) <u>16"</u> (2) total depth (feet) <u>105'</u> (3) static water level (feet) <u>20'</u> below top of ground. (4) casing <u>steel</u> , <u>55'</u> (material) (depth) <u>16"</u> If telescope see back. (size) (5) screen <u>50'</u> <u>55'</u> (length) (depth to top) <u>16"</u> <u>steel</u> (size) (material) (6) pump <u>60</u> <u>2800-3000</u> (HP) (yield gpm) <u>engine</u> (type power) (7) electric log _____ (yes or no) _____ (organization running log) (8) how well bottom plugged with plate _____			
DRILLERS REMARKS:			


CODED

FEB 24 1975

MISS. BD. OF WATER COMM.

If well telescopes please sketch and show depths.

GROUND LEVEL

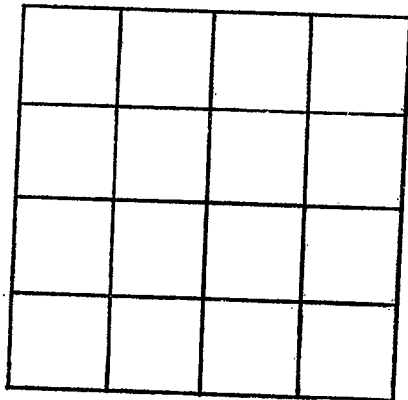

SECTION _____

Please indicate well location X.

ADDITIONAL INFORMATION

If more than one screen, show locations of each on sketch.