

WASHINGTON
E91
6-7-77

MISSISSIPPI
BOARD OF WATER COMMISSIONERS
416 North State Street
15H Jackson, Mississippi 39201

CODED

WATER WELL DRILLERS LOG

6-7

1977

Layne Central Co.

Washington

date well completed

firm name

county well located

LANDOWNER:	description of formations encountered	from	to
Delta Branch Exp. Station			
Stoney ville, MS (mailing address)	fine sand	25	38
WELL LOCATION:	clay	38	43
sec. 9 T. 18N R. 7W	sand (med) coarse	43	55
2 miles NW of Leland	coarse sand & pea gravel	55	62
(distance) (direction) of (nearest town)	coarse sand & gravel	62	101
WELL PURPOSE: Irrigation (home, irrigation, municipal, industrial)	clay	101	103
WELL COMPLETION DATA:			
(1) diameter (inches) 14"			
(2) total depth (feet) 103'			
(3) static water level (feet) 23' below top of ground.			
(4) casing Steel 53' (material) (depth) 14" if telescope see back. (size)			
(5) screen 50' 53' (length) (depth to top) 12" St. Steel (size) (material)			
(6) pump 40 1,000 (HP) (yield gpm) diesel (type power)			
(7) electric log No (yes or no)			
(organization running log)			
(8) how well bottom plugged St. Plate			
DRILLERS REMARKS:			

CODED


RECEIVED

SEP 16 1977

MISS. BD. OF WATER COMMISSIONERS

If well telescopes please sketch and show depths.

GROUND LEVEL

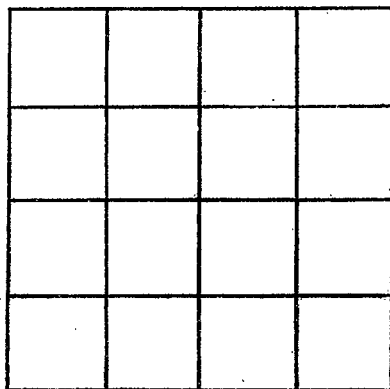

SECTION _____

Please indicate well location X.

ADDITIONAL INFORMATION

If more than one screen, show locations of each on sketch.