




If well telescopes please sketch and show depths.

GROUND LEVEL

140 4' 11"

167 2 1/2'

80 2 1/2'

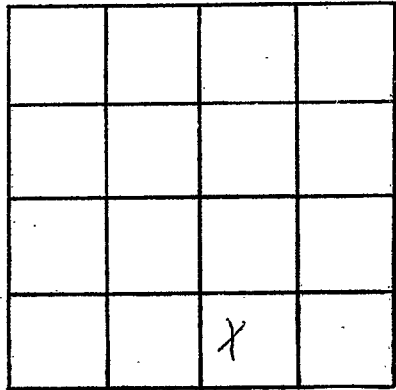

SECTION 8

Please indicate well location X.

ADDITIONAL INFORMATION

If more than one screen, show locations of each on sketch.