

WASHINGTON

CL-1042 E 25

5-1-79

MISSISSIPPI BOARD OF WATER COMMISSIONERS 416 North State Street Jackson, Mississippi 39201

CODED

WATER WELL DRILLERS LOG

May 1, 1979 Layne Central Company Washington date well completed firm name county well located

Table with columns: LANDOWNER, WELL LOCATION, WELL PURPOSE, WELL COMPLETION DATA, description of formations encountered, from, to. Includes entries for Delta Branch Exp. Station, Stoneville, MS, and various well completion details like diameter, depth, and casing.


CODED

Miss. Board of Water

RECEIVED

If well telescopes please sketch and show depths.

GROUND LEVEL

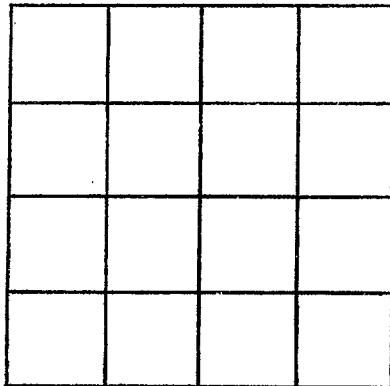

SECTION _____

Please indicate well location X.

ADDITIONAL INFORMATION

If more than one screen,
show locations of each on