


Washington
 CL-1694
E 98
8-25-80
 8/25

MISSISSIPPI
 BOARD OF WATER COMMISSIONERS
 416 North State Street
 Jackson, Mississippi 39201

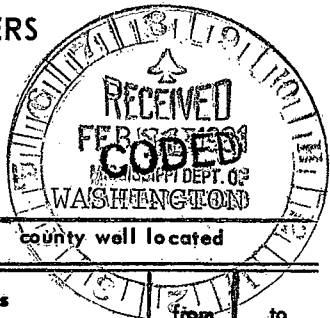

WATER WELL DRILLERS LOG


80 LAYNE-CENTRAL CO.

date well completed 19__ firm name county well located

LANDOWNER:	description of formations encountered	feet	
		from	to
AMERICAN HOECHST	clay	0	14
LELAND, MS	fine sand	14	22
(mailing address)	fine sand	22	42
WELL LOCATION:	fine sand	42	52
sec. <u>22</u> T. <u>18</u> N. R. <u>7</u> E.	med. coarse sand	52	62
<u>4</u> miles SW of LELAND	coarse sand	62	72
(distance) (direction) (nearest town)	coarse sand	72	82
WELL PURPOSE: IRRIGATION	coarse sand & gravel	82	92
(home, irrigation, municipal, industrial)	gravel	92	102
WELL COMPLETION DATA:			
(1) diameter (inches) <u>28"</u>			
(2) total depth (feet) <u>102'</u>			
(3) static water level (feet) <u>23'</u> below top of ground.			
(4) casing <u>Steel</u> <u>72'</u>			
(material) (depth)			
<u>12"</u>			
(size) If telescope see back.			
(5) screen <u>30'</u> <u>72'</u>			
(length) (depth to top)			
<u>12"</u> <u>St. Steel</u>			
(size) (material)			
(6) pump <u>30</u> <u>600</u>			
(HP) (yield gpm)			
<u>diesel</u>			
(type power)			
(7) electric log <u>no</u>			
(yes or no)			
(organization running log)			
(8) how well bottom plugged <u>St. Plate</u>			
DRILLERS REMARKS:			

If well telescopes please sketch and show depths.

GROUND LEVEL

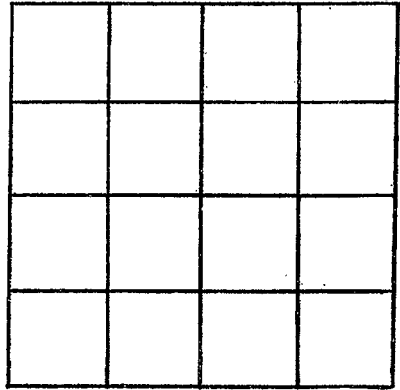

SECTION _____

Please indicate well location X.

ADDITIONAL INFORMATION

If more than one screen, show locations of each on sketch.