

WASHINGTON
E 99

4-4-81

MISSISSIPPI
BOARD OF WATER COMMISSIONERS
416 North State Street
Jackson, Mississippi 39201

CODED

WATER WELL DRILLERS LOG

4/4

date well completed

1981 Irrigation Well & Supply Wash.

firm name

county well located

LANDOWNER: WALKER
GEORGE WALKER
ARARAT FARMS

description of formations
encountered

from

to

STONEVILLE, MS
(mailing address)

TOP SOIL CLAY	0	10
CLAY & SAND	10	20
SAND	20	30
SAND	20	11.0
COARSE SAND	40	50
COARSE SAND & GRAVEL	50	60
" " "	60	70
" " "	70	80
" " "	80	90
" " "	90	98


WELL LOCATION:

sec 5 T 180 S R 7 E
5 miles W of STONEVILLE
(distance) (direction) (nearest town)

WELL PURPOSE: IRRIGATION
(home, irrigation, municipal, industrial)

WELL COMPLETION DATA:

- (1) diameter (inches) 16"
- (2) total depth (feet) 98'
- (3) static water level (feet) 20' below top of ground.
- (4) casing METAL 58'
(material) (depth)
16" If telescope see back.
(size)
- (5) screen 40' 58'
(length) (depth to top)
16" METAL
(size) (material)
- (6) pump 100 3000
(HP) (yield gpm)
DIESEL
(type power)
- (7) electric log (yes or no)
(organization running log)

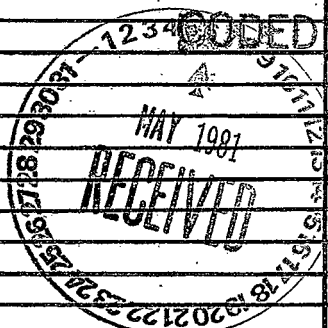

(8) how well bottom plugged
Welded PLATE

DRILLERS REMARKS:


MISSISSIPPI DEPARTMENT OF NATURAL RESOURCES
BUREAU OF LAND & WATER RESOURCES

MAY 6 1981

RECEIVED

If well telescopes please sketch and show depths.

GROUND LEVEL

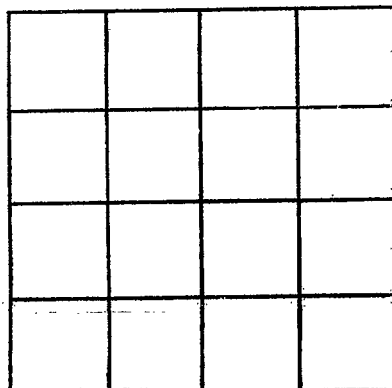

SECTION _____

Please indicate well location X.

ADDITIONAL INFORMATION

If more than one screen,
show locations of each on sketch.