

Washington
E 100
10-18-80

MISSISSIPPI
BOARD OF WATER COMMISSIONERS
416 North State Street
Jackson, Mississippi 39201


CODED

WATER WELL DRILLERS LOG

18 Oct 1980 Lambert Drilling Wash
date well completed firm name county well located

LANDOWNER:	description of formations encountered	from	to
Clark L. St. 82 E Greenville, Miss. (mailing address)			
WELL LOCATION: sec. 18 T. 18 N. R. 8 E 5 miles E of Green. (distance) (direction) (nearest town)	sand	20	60
WELL PURPOSE: ind. (home, irrigation, municipal, industrial)	sand & gravel	60	91
WELL COMPLETION DATA: (1) diameter (inches) 4x2 (2) total depth (feet) 440 (3) static water level (feet) 51 below top of ground. (4) casing PVC, 440 (material) (depth) 4x2 (size) if telescope see back. (5) screen 10, 440-430 (length) (depth to top) 2, 3.5 (size) (material) (6) pump 1, 20 (HP) (yield gpm) elect (type power) (7) electric log (yes or no) (organization running log) (8) how well bottom plugged back press.	blue shell	91	183
	Clay	183	205
	Clay st sand	205	295
	Sand med.	295	395
	Sand (coars)	395	450

CODED

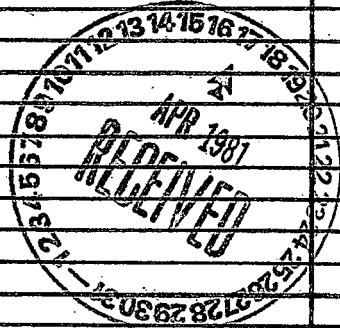

DRILLERS REMARKS:

If well telescopes please sketch and show depths.


14
2

GROUND LEVEL

140 4"

430 2"

440 2" 50 SCREEN

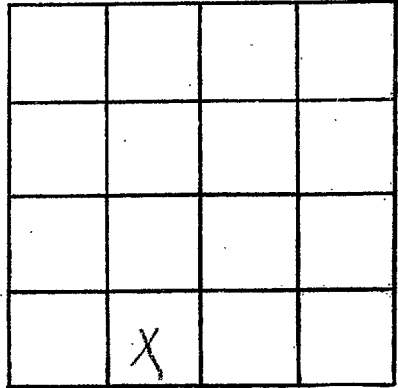

SECTION 18

Please indicate well location X.

ADDITIONAL INFORMATION

If more than one screen, show locations of each on sketch.