

Washington
E 101
6-25-80

MISSISSIPPI
BOARD OF WATER COMMISSIONERS
416 North State Street
Jackson, Mississippi 39201

WATER WELL DRILLERS LOG

6/25 1980 date well completed
Dyer firm name
Wash county well located

LANDOWNER:
C.A. TATE JR.
ELIZABETH MS
(mailing address)


description of formations encountered	from	to
Clay CODED	0	78
Just Sand	118	38
Sand	38	48
Sand + gravel	48	113

WELL LOCATION:
sec. 11 T. 18 N. R. 7 E. W. 1
1 miles W of Elizabeth
(distance) (direction) (nearest town)

WELL PURPOSE:
(home, irrigation, municipal, industrial)


- WELL COMPLETION DATA:
- (1) diameter (inches) 16
 - (2) total depth (feet) 113'
 - (3) static water level (feet) 22' below top of ground.
 - (4) casing Steel, 113',
(material) (depth)
16" if telescope see back.
(size)
 - (5) screen 40', 73'
(length) (depth to top)
16", Steel
(size) (material)
 - (6) pump 40 2000
(HP) (yield gpm)
Diesel
(type power)
 - (7) electric log _____
(yes or no)
 - (8) how well bottom plugged plate

DRILLERS REMARKS:

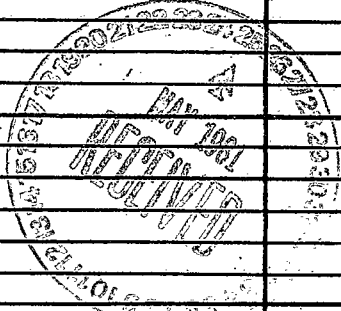

If well telescopes please sketch and show depths.

GROUND LEVEL

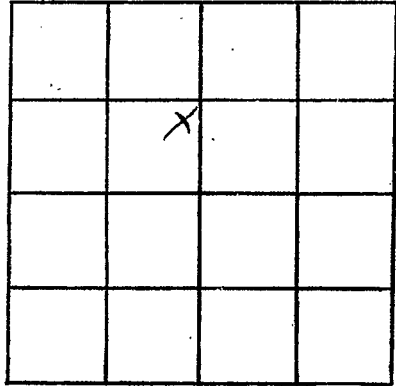

SECTION 11

Please indicate well location X.

ADDITIONAL INFORMATION

If more than one screen,
show locations of each on sketch.