

WASHINGTON

E103

12-7-79

MS-GW 4568

12/7

1979

Dun

Wash.

date well completed

firm name

county well located

MISSISSIPPI  
BOARD OF WATER COMMISSIONERS  
416 North State Street  
Jackson, Mississippi 39201

WATER WELL DRILLERS LOG

LANDOWNER:

MARK CORTIS

LELAND, MISS

(mailing address)

description of formations encountered

CODED

from

to

Clay

0

23

fine sand

23

38

sand

38

48

sand & gravel

48

113

WELL LOCATION:

sec. 25 T. 18 N. R. 7 E  
 4 miles N of Leland  
 (distance) (direction) (nearest town)


WELL PURPOSE:

(home, irrigation, municipal, industrial)

WELL COMPLETION DATA:

- (1) diameter (inches) 16"
- (2) total depth (feet) 113'
- (3) static water level (feet) 22' below top of ground.
- (4) casing Steel (material), 113' (depth), 16" (size) if telescope see back.
- (5) screen 40' (length), 73' (depth to top), 16" (size), Steel (material)
- (6) pump 60 (HP), 3000 (yield gpm), Diesel (type power)
- (7) electric log (yes or no)

CODED

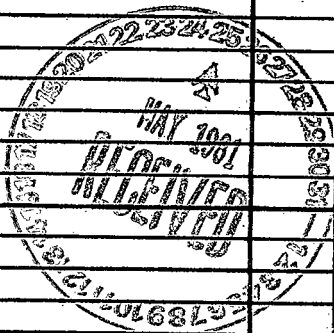


(organization running log)

(8) how well bottom plugged plate

DRILLERS REMARKS:

If well telescopes please sketch and show depths.

GROUND LEVEL

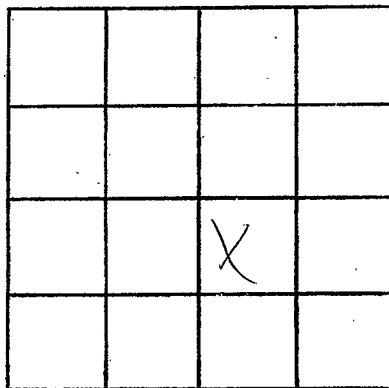

SECTION 7

Please indicate well location X.

ADDITIONAL INFORMATION

If more than one screen,  
show locations of each on sketch.