

MISSISSIPPI DEPARTMENT OF NATURAL RESOURCES

Bureau of Land and Water Resources

Southport Mall

P.O. Box 10631

Jackson, Mississippi 39209

WATER WELL DRILLERS LOG

CODED

WASHINGTON
E 104
8-15-81

8-15 1981 date well completed Irrigation Supply Company, Inc. firm name Washington county well located

LANDOWNER:
 U.S. DEPT. OF AGRICULTURE
 DELTA BRANCH EXP. STATION
 STONEVILLE, MISS.
 (mailing address)

description of formations encountered	from	to
Topsoil & clay	0	10
Fine Red sand	10	20
Fine grey sand	20	45
Course grey sand	45	85
(good)		
Course sand & gravel	85	92
(Excellent)		
Blue clay Bottom		92

WELL LOCATION:
 sec. 2 T. 18 N. R. 7 E.
 3 miles N of Stoneville
 (distance) (direction) (nearest town)

WELL PURPOSE: Irrigation
 (home, irrigation, municipal, industrial)

WELL COMPLETION DATA:

(1) diameter (inches) 16" 16"

(2) total depth (feet) 90'

(3) static water level (feet) 30' below above top of ground.

(4) casing Steel, 90'
 (material) (depth)
16" if telescope see back.
 (size)

(5) screen 40', 50'
 (length) (depth to top)
16", Steel
 (size) (material)

(6) pump 60 2000
 (HP) (yield gpm)
Diesel Powerunit
 (type power)

(7) electric log No
 (yes or no)
 (organization running log)

(8) how well bottom plugged welded plate

CODED

DEPT. OF NATURAL RESOURCES
 BUREAU OF LAND & WATER RESOURCES


SEP 15 1981

RECEIVED

DRILLERS REMARKS:
Good Formation

If well telescopes please sketch and show depths.

GROUND LEVEL

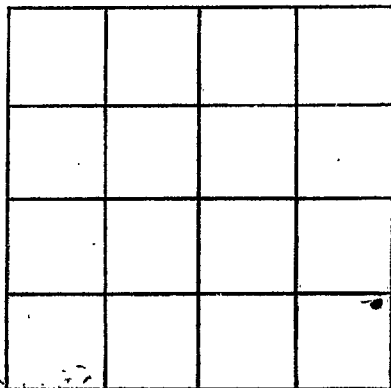

SECTION 2

Please indicate well location X.

ADDITIONAL INFORMATION

If more than one screen,
show locations of each on sketch.

