

Washington  
E 105  
6-27-81

MISSISSIPPI DEPARTMENT OF NATURAL RESOURCES  
Bureau of Land and Water Resources  
Southport Mall  
P.O. Box 10631  
Jackson, Mississippi 39209  
WATER WELL DRILLERS LOG

CODED

June 27, 1981 date well completed  
Larry's Well & Pump firm name  
Washington county well located

LANDOWNER: Bill Hemphill  
Leland MS.  
(mailing address)

description of formations encountered	from	to
CLAY	0	40
FINE SAND	40	70
MED & COARSE SAND	70	100

WELL LOCATION:  
sec. 28 T. 18 N R. 7 E  
3 miles SW of Leland  
(distance) (direction) (nearest town)

WELL PURPOSE:  
(home, irrigation, municipal, industrial)

- WELL COMPLETION DATA:
- (1) diameter (inches) 12"
  - (2) total depth (feet) 104'
  - (3) static water level (feet) 27' below top of ground.
  - (4) casing Steel, 14' (material) (depth)
  - (size) If telescope see back.
  - (5) screen 40' 64' (length) (depth to top)
  - 12" Steel (size) (material)
  - (6) pump 40 2000 (HP) (yield gpm)
  - (type power)
  - (7) electric log No. (yes or no)
  - (organization running log)
  - (8) how well bottom plugged Steel Plate

CODED

DEPT. OF NATURAL RESOURCES  
BUREAU OF LAND & WATER RESOURCES


JUN 15 1981

RECEIVED

DRILLERS REMARKS:

If well telescopes please sketch and show depths.

GROUND LEVEL

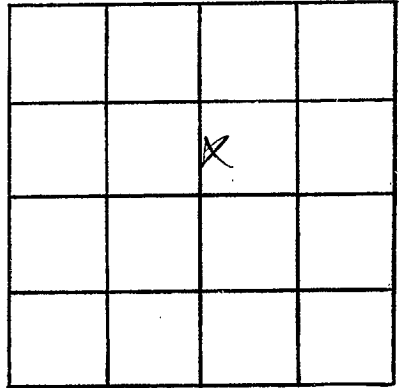

SECTION 28

Please indicate well location X.

ADDITIONAL INFORMATION

If more than one screen,  
show locations of each on sketch.