

MISSISSIPPI DEPARTMENT OF NATURAL RESOURCES

Bureau of Land and Water Resources

Southport Mall

P.O. Box 10631

Jackson, Mississippi 39209

WATER WELL DRILLERS LOG

CODED

Washington
 CL-1830
E 106
6-24-81
 6-24-81

LAYNE-CENTRAL CO.

WASHINGTON

date well completed

firm name

county well located

LANDOWNER:

Livingston Farms

Elizabeth, MS

(mailing address)

description of formations encountered

from

to

clay	0	15
brown sand	15	34
coarse sand	34	58
c. sand - p. gravel	58	78
c. sand - gravel	78	108
c. sand	108	115
el. sand - gravel	115	120

WELL LOCATION:

sec 2 T 18 N R 7 E
 & W
2 miles N. of LEGARD
 (distance) (direction) (nearest town)

WELL PURPOSE: irrigation
 (home, irrigation, municipal, industrial)

WELL COMPLETION DATA:

- (1) diameter (inches) 28"
- (2) total depth (feet) 120'
- (3) static water level (feet) 17 1/8" below top of ground.
- (4) casing steel 90'
 (material) (depth)
12"
 (size) if telescope see back.
- (5) screen 30' 90'
 (length) (depth to top)
12" st. steel
 (size) (material)
- (6) pump 40 1000
 (HP) (yield gpm)
DIESEL
 (type power)
- (7) electric log no
 (yes or no)

(organization running log) st. plate

(8) how well bottom plugged

DRILLERS REMARKS:

CODED


DEPT. OF NATURAL RESOURCES
 BUREAU OF LAND & WATER RESOURCES

OCT 20 1981

RECEIVED

If well telescopes please sketch and show depths.

GROUND LEVEL

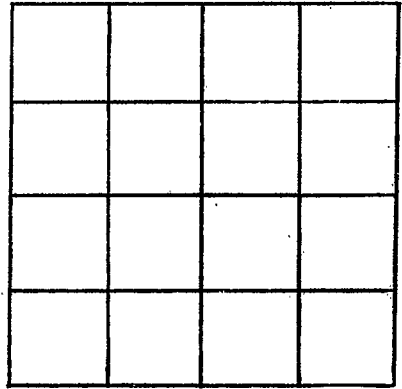

SECTION _____

Please indicate well location X.

ADDITIONAL INFORMATION

If more than one screen,
show locations of each on sketch.