

**MISSISSIPPI DEPARTMENT OF NATURAL RESOURCES**  
**Bureau of Land and Water Resources**  
 Southport Mall  
 P.O. Box 10631  
 Jackson, Mississippi 39209  
**WATER WELL DRILLERS LOG**

WASHINGTON  
~~2278~~  
8-24-82

**E 110**

8-24 1982      Rayne Central Co.      Washington  
 date well completed      firm name      county well located

**LANDOWNER:**  
Stoneville Ped. Seed  
Stoneville, Ms  
 (mailing address)

**WELL LOCATION:**  
 sec. 10 T 18 N      R. 7 W  
 (distance)      (direction)      (nearest town)

miles \_\_\_\_\_ of Stoneville

description of fomations encountered	from	to
<u>clay</u>	<u>0</u>	<u>15</u>
<u>fine sand</u>	<u>15</u>	<u>46</u>
<u>coarse sand</u>	<u>40</u>	<u>56</u>
<u>C. sand &amp; pea gravel</u>	<u>50</u>	<u>100</u>
<u>gravel</u>	<u>100</u>	<u>120</u>
<u>clay</u>	<u>120</u>	<u>200</u>
<u>shale</u>	<u>200</u>	<u>256</u>
<u>sandy clay</u>	<u>250</u>	<u>348</u>
<u>shale</u>	<u>340</u>	<u>370</u>
<u>sandy shale</u>	<u>370</u>	<u>412</u>
<u>white sand</u>	<u>412</u>	<u>476</u>
<u>clay</u>	<u>476</u>	<u>480</u>

**WELL PURPOSE:** home  
 (home, irrigation, municipal, industrial)

**WELL COMPLETION DATA:**

(1) diameter (inches) 15"

(2) total depth (feet) 483'

(3) static water level (feet) 46' below top of ground.

(4) casing steel (material), 147'6" (depth)  
6" (size) if telescope see back.

(5) screen 31'4" (length), 452'10" (depth to top)  
4" (size), st steel (material)

(6) pump 5 (HP), 60 (yield gpm)  
electric (type power)

(7) electric log No (yes or no)  
 (organization running log)

**CODED**

(8) how well bottom plugged at plate


**DRILLERS REMARKS:**

DEPT. OF NATURAL RESOURCES  
 BUREAU OF LAND & WATER RESOURCES

DEC 16 1982  
**RECEIVED**

If well telescopes please sketch and show depths.

GROUND LEVEL

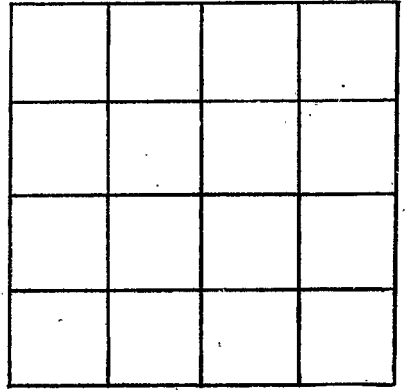

SECTION \_\_\_\_\_

Please indicate well location X.

ADDITIONAL INFORMATION

If more than one screen,  
show locations of each on sketch.