

MISSISSIPPI DEPARTMENT OF NATURAL RESOURCES

Bureau of Land and Water Resources

Southport Mall

P.O. Box 10631

Jackson, Mississippi 39209

WATER WELL DRILLERS LOG

WASHINGTON
E-112
3/30/83

3-30-83
date well completed

Schultz Drilling
firm name

Washington
county well located

LANDOWNER: J.W. Potter
Stoneville, MS.

(mailing address)

WELL LOCATION:

sec. 5 T-18 N R-7 E
S W Stoneville
2 miles (distance) W (direction) of Stoneville (nearest town)

WELL PURPOSE:

(home, irrigation, municipal, industrial)

WELL COMPLETION DATA:

- (1) diameter (inches) 4" X 3"
- (2) total depth (feet) 490'
- (3) static water level (feet) 25' below top of ground.
- (4) casing PVC (material), 460' (depth)
- (size) if telescope see back.
- (5) screen 30' (length), 460' (depth to top)
- 3" (size), PVC (material)
- (6) pump 3 (HP), 72 (yield gpm)
- EIE (type power)
- (7) electric log NO (yes or no)
- X (organization running log)
- (8) how well bottom plugged B/W

description of formations encountered

from

to

CLAY	0	20
SAND gravel	20	130
Shale	130	390
SAND	390	490

CODED



DEPT. OF NATURAL RESOURCES
BUREAU OF LAND & WATER RESOURCES

APR 20 1983

RECEIVED

DRILLERS REMARKS:

If well telescopes please sketch and show depths.

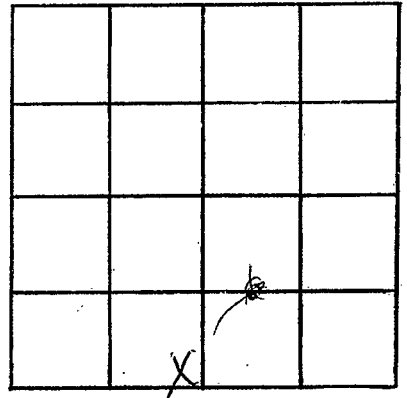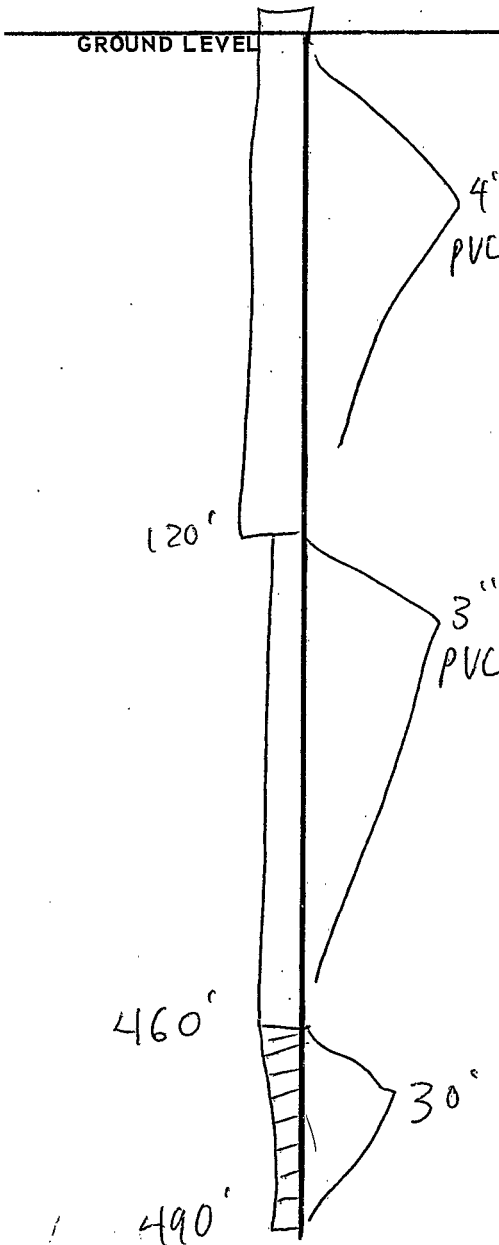

SECTION S

Please indicate well location X.

ADDITIONAL INFORMATION

A series of horizontal lines for providing additional information.

If more than one screen, show locations of each on sketch.