

MISSISSIPPI DEPARTMENT OF NATURAL RESOURCES

Bureau of Land and Water Resources

Southport Mall

P.O. Box 10631

Jackson, Mississippi 39209

WATER WELL DRILLERS LOG

CODED

Washington  
E 113  
5710182

5-11-82 date well completed  
Super Well firm name  
Washington county well located

LANDOWNER: Billy Johnson

description of formations encountered

from to

(mailing address)

Clay 0 26  
Fine sand 26 48  
Sand 48 57  
Sand & Gravel 57 123

WELL LOCATION:  
sec. 17 T. 18 N. R. 7 E  
S W  
1 miles SE of Leard  
(distance) (direction) (nearest town)

WELL PURPOSE:  
(home, irrigation, municipal, industrial)

WELL COMPLETION DATA:

- (1) diameter (inches) 10
- (2) total depth (feet) 103
- (3) static water level (feet) 18 below top of ground.
- (4) casing 4" PVC 63  
(material) (depth)  
10" if telescope see back.  
(size)
- (5) screen 2040 63  
(length) (depth to top)  
2040 galvanized PVC  
(size) (material)
- (6) pump 20 1200  
(HP) (yield gpm)  
electric  
(type power)
- (7) electric log No  
(yes or no)  
NONE  
(organization running log)
- (8) how well bottom plugged Plate

CODED

DEPT. OF NATURAL RESOURCES  
BUREAU OF LAND & WATER RESOURCES


MAY 14 1992

DRILLERS REMARKS:

RECEIVED

If well telescopes please sketch and show depths.

GROUND LEVEL

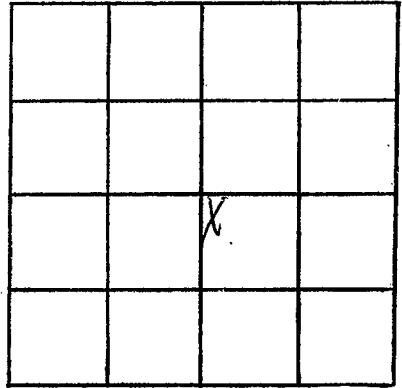

SECTION 17

Please indicate well location X.

ADDITIONAL INFORMATION

If more than one screen, show locations of each on sketch.