

E 114

MISSISSIPPI
BOARD OF WATER COMMISSIONERS
416 North State Street
Jackson, Mississippi 39201

CODED

9-16-83

WATER WELL DRILLERS LOG

9-16
date well completed

1983 Schultz Drilling
firm name

Washington
county well located

LANDOWNER: C.G. Steele
Longwood Farms
Greenville MS.
(mailing address)

description of fomations encountered

from to

CLAY 0 24
SAND 24 60
SAND + GRAVEL 60 80

WELL LOCATION:

sec. 30 T. 18 R. 7
4 miles E of Greenville
(distance) (direction) (nearest town)

WELL PURPOSE: IRRIGATION
(home, irrigation, municipal, industrial)

CODED

WELL COMPLETION DATA:

- (1) diameter (inches) 10"
- (2) total depth (feet) 80'
- (3) static water level (feet) 28' below above top of ground.
- (4) casing PVC 40' (material) (depth)
- (size) if telescope see back.
- (5) screen 40' 40' (length) (depth to top)
10" PVC (size) (material)
- (6) pump 20 1000 (HP) (yield gpm)
ELE (type power)
- (7) electric log NO (yes or no)

(organization running log)

(8) how well bottom plugged PVC CAP

DRILLERS REMARKS:


DEPT. OF NATURAL RESOURCES
BUREAU OF LAND & WATER RESOURCES

SEP 26 1983

RECEIVED

If well telescopes please sketch and show depths.

GROUND LEVEL

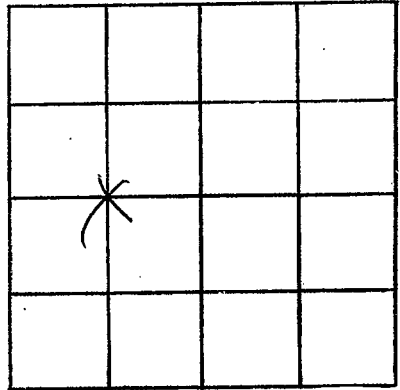

SECTION 30

Please indicate well location X.

ADDITIONAL INFORMATION

If more than one screen, show locations of each on sketch.