

MISSISSIPPI DEPARTMENT OF NATURAL RESOURCES
Bureau of Land and Water Resources
 Southport Mall
 P.O. Box 10631 **CODED**
 Jackson, Mississippi 39209
WATER WELL DRILLERS LOG

E116
~~EL-2567~~ Washington
8-27-83

8/27 19 83 LAYNE-CENTRAL WASHINGTON
 date well completed firm name county well located

LANDOWNER:
Livingston Farms
Ieland, MS
 (mailing address)

description of formations encountered	from	to
clay	0	17
sand	17	35
coarse sand pea gravel	35	75
coarse sand gravel	75	107
pink clay	107	112

WELL LOCATION:
 sec. 24 T 18 N R 7 W
12 E Elizabeth
 (distance) miles (direction) of (nearest town)

WELL PURPOSE:
 (home, irrigation, municipal, industrial)

WELL COMPLETION DATA:

(1) diameter (inches) 32"

(2) total depth (feet) 107'

(3) static water level (feet) 24' below above top of ground.

(4) casing steel, 57'
 (material) (depth)
16" if telescope see back.
 (size)

(5) screen 50', 57'
 (length) (depth to top)
16", st. steel
 (size) (material)

(6) pump 60, 2500
 (HP) (yield gpm)
diesel
 (type power)

(7) electric log no
 (yes or no)
(organization running log)

(8) how well bottom plugged st. plate

CODED

DEPT. OF NATURAL RESOURCES
 BUREAU OF LAND & WATER RESOURCES


JAN 10 1984

DRILLERS REMARKS:

RECEIVED

If well telescopes please sketch and show depths.

GROUND LEVEL

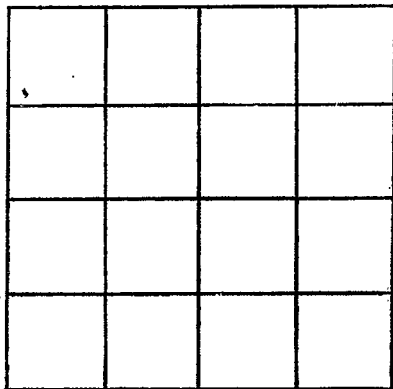

SECTION _____

Please indicate well location X.

ADDITIONAL INFORMATION

If more than one screen,
show locations of each on sketch.