

MISSISSIPPI DEPARTMENT OF NATURAL RESOURCES

CODED

Bureau of Land and Water Resources

Southport Mall

P.O. Box 10631

Jackson, Mississippi 39209

WATER WELL DRILLERS LOG

E117
 Washington Co
 2-27-84

2/27/84 19
 date well completed

Powell Irrigation Washington
 firm name county well located


LANDOWNER:	description of formations encountered	from	to
Mississippi State Experimental Station Stoneville (Delta Branch) Leland, MS (mailing address)	Clay Clay + med. coarse sand Coarse sand + small gravel Big gravel + sand	0 20 40 90	20 40 90 110
WELL LOCATION: sec. 10 T 18 N S R 7 E W 1 1/2 miles North of Leland (distance) (direction) (nearest town)			
WELL PURPOSE: <u>Irrigation</u> (home, irrigation, municipal, industrial)			
WELL COMPLETION DATA:			
(1) diameter (inches) <u>12"</u>			
(2) total depth (feet) <u>110'</u>			
(3) static water level (feet) <u>20'</u> below top of ground.			
(4) casing <u>Steel</u> , <u>70'</u> (material) (depth) <u> </u> if telescope see back. (size)			
(5) screen <u>40'</u> , <u>70'</u> (length) (depth to top) <u>12"</u> , <u>Steel</u> (size) (material)			
(6) pump <u>60</u> <u>900</u> (HP) (yield gpm)			
<u>Diesel</u> (type power)			
(7) electric log <u>NO</u> (yes or no)			
<u> </u> (organization running log)			
(8) how well bottom plugged: <u>Steel Plate</u>			
DRILLERS REMARKS:			

DEPT. OF NATURAL RESOURCES
 BUREAU OF LAND & WATER RESOURCES

MAR 29 1984
RECEIVED

If well telescopes please sketch and show depths.

GROUND LEVEL

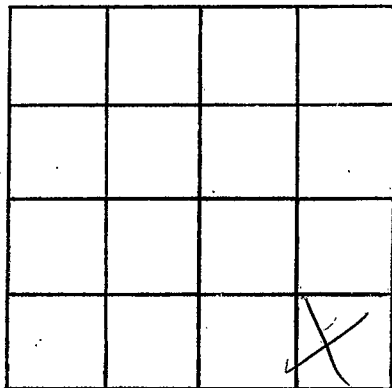

SECTION 10

Please indicate well location X.

ADDITIONAL INFORMATION

If more than one screen,
show locations of each on sketch.