

WASHINGTON
E 118

MISSISSIPPI DEPARTMENT OF NATURAL RESOURCES
Bureau of Land and Water Resources
Southport Mall
P.O. Box 10631
Jackson, Mississippi 39209
WATER WELL DRILLERS LOG

CODED

4-18 1984
date well completed

Larry's wells pump Washington
firm name county well located

LANDOWNER: Jimmy Reed
Leland miss
(mailing address)

description of formations encountered	from	to
clay	0	30
Fine Sand	30	70
coarse Sand	70	116

WELL LOCATION:
sec. 22 T 18 N
S R E W
1 miles S 7 W of Leland
(distance) (direction) (nearest town)

CODED

WELL PURPOSE:
(home, irrigation, municipal, industrial)


- WELL COMPLETION DATA:
- (1) diameter (inches) 16"
 - (2) total depth (feet) 116'
 - (3) static water level (feet) 22 below above top of ground.
 - (4) casing Steel (material), 76' (depth),
(size) if telescope see back.
 - (5) screen 40' (length), 76' (depth to top),
16" (size), Steel (material)
 - (6) pump 60 (HP), 1000 (yield gpm)
D (type power)
 - (7) electric log no (yes or no)
(organization running log)
 - (8) how well bottom plugged Steel Plate

MISSISSIPPI DEPARTMENT OF NATURAL RESOURCES
BUREAU OF LAND & WATER RESOURCES
OCT 12 1984
RECEIVED

DRILLERS REMARKS:

If well telescopes please sketch and show depths.

GROUND LEVEL

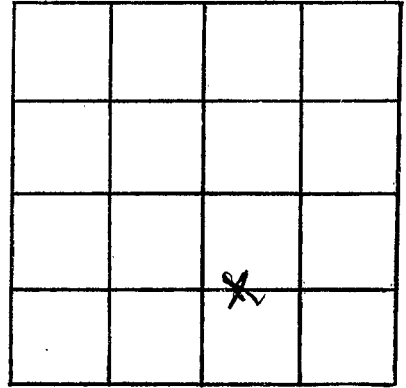

SECTION 22

Please indicate well location X.

ADDITIONAL INFORMATION

If more than one screen,
show locations of each on sketch.