

MISSISSIPPI DEPARTMENT OF NATURAL RESOURCES

Bureau of Land and Water Resources

Southport Mall

P.O. Box 10631

Jackson, Mississippi 39209

WATER WELL DRILLERS LOG

CODED

WASHINGTON

E 119

John Patern Chester

3-13-85

19 IRRIGATION EQUIPMENT

WASHINGTON

date well completed

firm name

county well located

LANDOWNER: Gib Steel

description of formations encountered

from

to

Longwood Farms Rt. 1, Box L

Clay

0

20

Hollandale, MS 38748

fine sand

20

55

(mailing address)

course sand

55

95

WELL LOCATION:

course sand / GRAVEL

95

115

sec. 30 T. 18 (N) S R. 7 (E) W

5

miles SW

of LELAND

(distance)

(direction)

(nearest town)

WELL PURPOSE: IRRIGATION

(home, irrigation, municipal, industrial)

WELL COMPLETION DATA:

(1) diameter (inches)

10"

(2) total depth (feet)

115

(3) static water level (feet)

13

below above

top of ground.

(4) casing

PVC

75'

(material)

(depth)

if telescope see back.

(5) screen

40'

75'

(length)

(depth to top)

12"

PVC

(size)

(material)

(6) pump

10⁰

700

(HP)

(yield gpm)

ELECTRIC

(type power)

(7) electric log

NO

(yes or no)

(organization running log)

(8) how well bottom plugged

PVC CAP

DRILLERS REMARKS:


CODED

RECEIVED
APR 28 1995

Department of Natural Resources
Bureau of Land & Water Resources

If well telescopes please sketch and show depths.

GROUND LEVEL

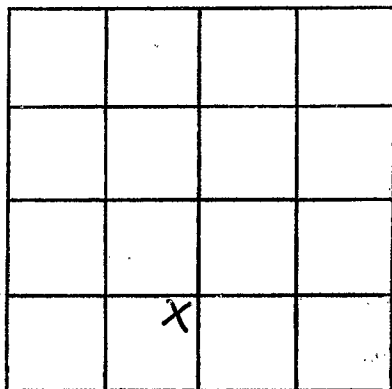

SECTION 30

Please indicate well location X.

ADDITIONAL INFORMATION

If more than one screen,
show locations of each on sketch.