

Washington
E 123

MISSISSIPPI DEPARTMENT OF NATURAL RESOURCES
 Bureau of Land and Water Resources
 Southport Mall
 P.O. Box 10631
 Jackson, Mississippi 39209
WATER WELL DRILLERS LOG

CODED

5-28 19 87 Schultz Drilling Washington
 date well completed firm name county well located

LANDOWNER: P.O. Baker
Hwy 82 E
Leland MS
 (mailing address)

description of formations encountered	from	to
	CLAY SAND	0
SAND + gravel	25	75
	75	110

WELL LOCATION:
 sec 23 T. 8 N. R. 7 E
1/2 miles E of Leland
 (distance) (direction) (nearest town)

CODED

WELL PURPOSE: IRRIGATION
 (home, irrigation, municipal, industrial)

WELL COMPLETION DATA:

- (1) diameter (inches) 16"
- (2) total depth (feet) 110'
- (3) static water level (feet) 31' ^{below} _{above} top of ground.
- (4) casing PVC 90
 (material) (depth)
- _____ if telescope see back.
 (size)
- (5) screen 30 90'
 (length) (depth to top)
- 16" steel
 (size) (material)
- (6) pump 60 2500
 (HP) (yield gpm)
- gear drive
 (type power)
- (7) electric log no
 (yes or no)
- X
 (organization running log)
- (8) how well bottom plugged CAP

RECEIVED


JUL 3 1987

Department of Natural Resources
 Bureau of Land & Water Resources

DRILLERS REMARKS:

If well telescopes please sketch and show depths.

GROUND LEVEL

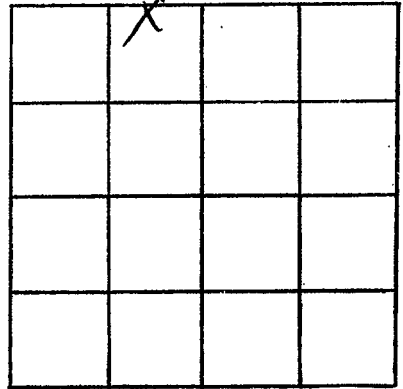

SECTION 23

Please indicate well location X.

ADDITIONAL INFORMATION

If more than one screen,
show locations of each on sketch.