


If well telescopes please
sketch and show depths.

GROUND LEVEL

IRRIGATION EQUIPMENT
GOL, 887-2505
INMOBILE, MS

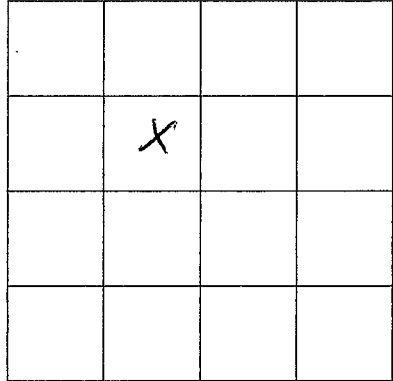

SECTION 24

Please indicate well location X.

ADDITIONAL INFORMATION

If more than one screen,
show location of each on sketch.