

MISSISSIPPI DEPARTMENT OF NATURAL RESOURCES

Bureau of Land and Water Resources

Southport Mall

P.O. Box 10631

Jackson, Mississippi 39209

WATER WELL DRILLERS LOG

WASHINGTON
E 128 CODED

5-30 1988 Scholtz Drilling Washington
date well completed firm name county well located

LANDOWNER: <u>Steele Farms</u>	description of formations encountered	from	to
<u>Rt. 1, Box "L"</u>			
<u>Hollandale ms. 38748</u> (mailing address)	<u>CLAY</u> <u>COARSE SAND</u> <u>SAND + peagravel</u>	<u>0</u> <u>10</u> <u>60</u>	<u>10</u> <u>60</u> <u>85</u>
WELL LOCATION:			
sec. <u>30</u> T. <u>18</u> N. R. <u>7</u> E <u>3</u> miles <u>W</u> of <u>Lebad</u> (distance) (direction) (nearest town)			
WELL PURPOSE: <u>IRRIGATION</u> (home, irrigation, municipal, industrial)			
WELL COMPLETION DATA:			
(1) diameter (inches) <u>16"</u>			
(2) total depth (feet) <u>85'</u>			
(3) static water level (feet) <u>29</u> below above top of ground.			
(4) casing <u>PVC</u> <u>65'</u> (material) (depth)			
_____ If telescope see back. (size)			
(5) screen <u>20'</u> <u>65'</u> (length) (depth to top)			
<u>16"</u> <u>PVC</u> (size) (material)			
(6) pump <u>40</u> <u>1200</u> (HP) (yield gpm)			
<u>pfo</u> (type power)			
(7) electric log <u>No</u> (yes or no)			
_____ <input checked="" type="checkbox"/> (organization running log)			
(8) how well bottom plugged <u>CAP</u>			
DRILLERS REMARKS:			


RECEIVED

JUN 16 1988

Department of Natural Resources
Bureau of Land & Water Resources

If well telescopes please sketch and show depths.

GROUND LEVEL

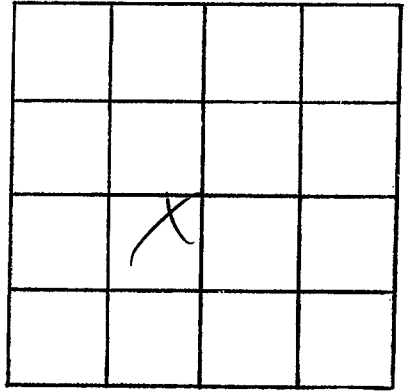

SECTION 50

Please indicate well location X.

ADDITIONAL INFORMATION

If more than one screen, show locations of each on sketch.