County: Washington Permit #: <u>6</u> <u>W</u> - <u>37726</u> Irrigation Equipment Driller: <u>6-16-04</u> State Law requires that this rep	State Well Report Part 1 Mississippi Department of Environ Office of Land and Water Rd P.O. Box 10631 Jackson, MS 39289-06 (601)961-5210 (601)354-6938 (fax) ort be prepared by the driller in department	mental Quality Aquifer esources Well #: 31 L. S. Ek E-log #:	For Office Use Only: 
30 days of completion of drilling Well Owner Inform	s of the well.	Well Location	
Owner NameBourbon Plant	ation Latitude: 3	3.25 ,24 " Longi	
Mailing Address: Box 387		at/Long (circle one): Conv	
		quad, Hand-held GPS, Su	•
Leland, MS	38756	$\frac{W}{W}$ 4 Sec 7 Two	
City St	ate Zip Code		
<b>Telephone No.</b> $(\frac{662}{5}, \frac{686}{4672})$	Distance	Direction Near liles <u>NE</u> of	rest Town Leland
· ·	Well Data		
	6-04 Date well drilling c   lve Other (describe)   pove or below (circle one) land surface   teel tape electric tape   teel tape electric tape   pth: 114'   Well grout   Bentonite Mix   ng diameter: 16   inches   sen diameter: 16   jonches   Setting depth: From   75	Date measured:6-1 Date measured:6-1 other: ted to a depth of10 PVC Sch Type of screef: VC Sch feet to114	9-04 feet . 40
Top of lap pipe or reduction in casing:	feet. If telescoped or n	ore than one screen, desc	tibe on back of page
Logs run (circle all applicable): No log ru	n) Electric Gamma Ray Density S	onic Neutron Other:	· .
Name of organization running log(s):			·
I certify that the well was drilled, constr Department of Environmental Quality a Irrigation Equipmen	nd/or the Mississippi Department of H nt Inc. )695		have
······································			
			SEP 07 20
			BY: OLV
	· .		01.00

If well telescopes please sketch below and show depths.




	Description of Formations Encountered	From	То
C1	ay	0	15
<u>Fi</u>	ne_Sand	16	27
<u>Fi</u>	ne Sand/gravel	28	50
Me	d. Sand/gravel	51	114
· -	· · · · · · · · · · · · · · · · · · ·		
			<b></b>
	·····		
			<b>  </b>
			<b> </b>
	<u></u>		
			╂
/ ·	· · · · · · · · · · · · · · · · · · ·		┨───┤
	· · · · · · · · · · · · · · · · · · ·		┨───┤
			<b> </b>
	······································		
			╄━━━━┫
			╂
			<b></b>
			╂ไ
	<u> </u>		
1			

E-175

If more than one screen, show location of each on sketch

Signature of Water Well Contractor

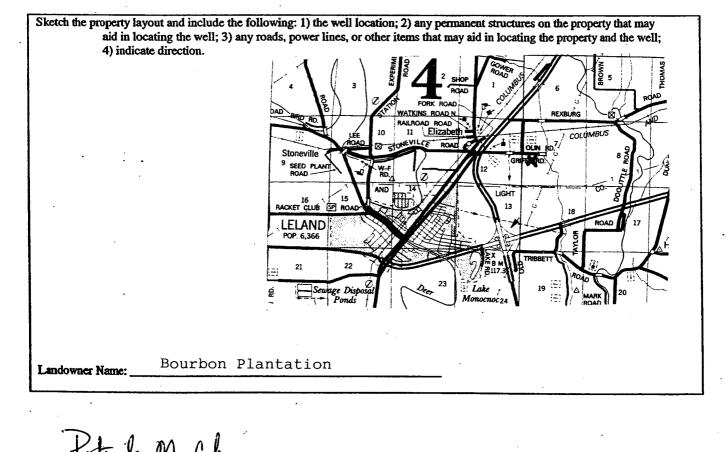

County: <u>Washington</u> Permit #: <u>GW- 39726</u> Irrigation Equipment Driller: <u>6-19-04</u> Date completed: <u>6-19-04</u>	Jackson, MS 39289-0631 (601)961-5210 (601)354-6938 (fax)		For Office Use Only: Aquifer: Well #: <u>F-175</u> Elevation:
This report should be prepared by th installation of pump. Well Owner Informati			Location
Owner Name: Bourbon Planta			Longitude:
Mailing Address: Box 387		Method of Lat/Long (circle on	
Leland, MS City State 662-686-4672 Telephone No.	Zip Code	USGS quad, Hand	-held GPS, Survey-grade GPS 7 Twn 18N Rng 7W Nearest Town
Pump Type Circle one Air Lift Jet	Submersible	Ci	ver Type rcle one e Engine Natural Gas
Bucket Piston	Turbine	Blectric Motor Hand	Tractor PTC
Centrifugal Rotary	Flowing Well		specify):
Other (specify):		Horse Power Rating of Motor:	
Date Pump Installed: $6-19-04$ 2500-3000		Setting Depth:	70 feet
Rated Pump Capacity:	Gallons Per Minute	Number of Stages:1	
Pump Test Data		Method of Measuring Water Level Circle one	
-			
Date Well Tested:	Below Land Surface	Air Line Electric Meas	
Date Well Tested: Static Water Level (A):25Feet 1	Below Land Surface Below Land Surface	Air Line Electric Meas	suring Line Steel Tape
Date Well Tested: Static Water Level (A): Feet I Pumping Water Level (B): Feet F	Below Land Surface Below Land Surface Below Land Surface	Air Line Electric Mean Other (specify):	suring Line Steel Tape

RECEIVED SEP 0 7 2004 BY: OLWR