monsanto creek well

County: WISHINGTON Permit #: GW 42095 Driller: J. NEWGME 0-773 Date drilling completed: 7-19-07 State Well Report Part 1 Mississippi Department of Environmental Quality Office of Land and Water Resources P.O. Box 10631 Jackson, MS 39289-0631 (601)961-5210 (601)354-6938 (fax)

For Office Use Only:	
Aquifer:	
Well #: <u>E-182</u>	
L. S. Elevation:	
E-log #:	

State Law requires that this report be prepared by the driller in detail and filed with the Department within


30 days of completion of drilling of the well.		
Well Owner Information	Well Location 09	
Owner Nartho MONSANTO LELAND AG CENTER	Latitude: 33. 25. 54" Longitude: 090 57. 68	
Mailing Address: Po Rox 388	Method of Lat/Long (circle one): Conventional Survey,	
•	USGS quad, Hand-held GPS, Survey-grade GPS	
STONEVILLE MS. 38776 City State Zip Code Telephone No. 662-378-102/	SW 1/2 SW 1/2 Sec #8 TWN 18H RNg TW	
Telephone No. 662-378-102/	Distance Direction Nearest Town 3 Miles NW of LELAND	
Well 1	Data	
Purpose of Well (circle one) Home Industrial Public Supply		
Date well drilling started: 7-19-07 Date	well drilling completed: 7-19-07	
If flowing, method of flow regulation: Valve Other (c	lescribe)	
Static Water Level:feet above or below (circle one)	land surface Date measured:	
Method of Measurement (circle one) steel tape electric tape	air line other:	
Hole depth: 93 Well depth: 90 Well grouted to a depth of 10 RECEIVE		
Type of grout (circle one): Cement Bentonite Mix		
Casing length: 61 feet Casing diameter: 16 inches Type of casing: PVC BY: 01/14/		
Screen length: 29 feet Screen diameter: 16 inches Type of screen: PVC		
Screen slot size: 050 inches Setting depth: From 50-65 71-75 So-93 feet		
Type of completion (circle all applicable): Gravel packed Underreamed Telescoped Open hole Natural Development		
Other (describe):		
Top of lap pipe or reduction in casing:feet. If telescoped or more than one screen, describe on back of page		
Logs run (circle all applicable): No log run Electric Gamma Ray Density Sonic Neutron Other:		
Name of organization running log(s):		
I certify that the well was drilled, constructed, and completed in accordance with all applicable requirements of the Mississippi		
Department of Environmental Quality and/or the Mississippi Department of Health regulations and state laws.		
JOHN NEWCOME 0-773	2d verseul	
Print Name of Water Well Contractor and License No.	Signature of Water Well Contractor	

Ground I	evel
----------	------

12101	
	CASING _ 50
Screen —	-65 casing
Scient	- 75 CASTMY SD
screw	_90

Description of Formations Encountered	From	To
10P >01	0	10
mir CIA9	10	40
fine sant	40	50
COArse Sand	50	42
Fine Sand	65	71
COATSE SANE	71	75
fore sand	75-	80
COArse Sant	80	६०
Gray Clay	ÇO	83
		L

If more than one screen, show location of each on sketch

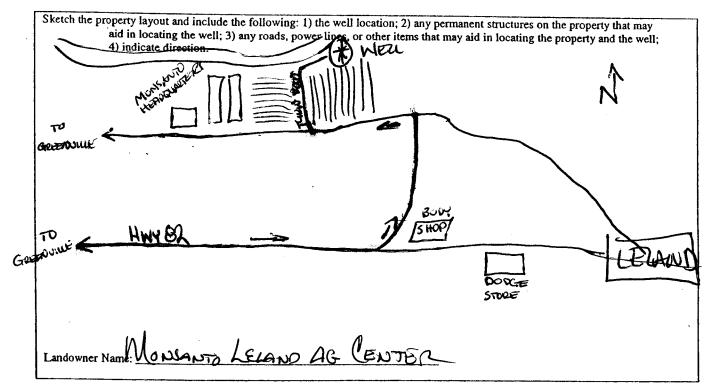

Signature of Water Well Contractor

County: LASH, NETON Permit #: 6 W 42095 Driller NEWCome 0-773 Date completed: 7-19-07

Part 2

Pump Installer's Completion Report Mississippi Department of Environmental Quality Office of Land and Water Resources

P.O. Box 10631 Jackson, MS 39289-0631 (601)961-5210 (601)354-6938 (fax)

F	or Office U	se Only:
Aquifer:		
Well #:	E-	182
Elevation	1:	

This report should be prepared by the pump installer in detail and filed with the Department within 30 days of the installation of pump.

installation of pump.		
Well Owner Information	Well Location	
Owner Name MONSANTO LELAND AG CENTE	Latitude: 33-2551 Longitude 090 - 57-09	
Mailing Address: 10 Pox 388	Method of Lat/Long (circle one): Conventional Survey,	
:	USGS quad, Hand-held GPS, Survey-grade GPS	
STONEYS : 1 Mc 3877/	Sw 1/4 Sw 1/4 Sec 5 Twn / 8 Rng 7 W	
City State Zip Code	30 4 500 14 Sec 5 Twn 180 Rng 100	
	Distance Direction Nearest Town	
Telephone No. 262 - 378 - 1021	3 Miles NW of LELAND	
Pump Type		
Circle one	Power Type Circle one	
Air Lift Jet Submersible	Diesel Engine Gasoline Engine Natural Gas	
Bucket Piston Turbine	Electric Motor Hand Tractor PTO	
Centrifugal Rotary Flowing Well	Windmill Other (specify):	
Other (specify):	Horse Power Rating of Motor:	
Date Pump Installed: 7-20-07	Setting Depth:feet	
Rated Pump Capacity:Gallons Per Minute	Number of Stages: 2 Stage RECEIVE	
	Auc	
Pump Test Data Date Well Tested:	Method of Measuring Water Level 6 2007 Circle one	
Static Water Level (A):Feet Below Land Surface	Air Line Electric Measuring Line Steel Tape	
Pumping Water Love (1): Estreet Beloward Surface	Other (specify):	
V		
Drawdown [(B) - (A)]:Feet Below Land Surface	For flowing well, measured shut in head:feet	
Test Pumping Rate: Gallons Per Minute	Well yieldedGPM with a drawdown of	
Duration of Pump Test (minimum 4 hours):hours	feet afterhours of pumping	
I HEREBY CERTIFY that the above statements are true to the best of my knowledge.		
Print Name of Pump Installer and License No. (if applicable)	Signature of Pump Installer	
CLEN KOWÉ		