

Mon santo

State Well Report

Part 1

Mississippi Department of Environmental Quality
Office of Land and Water Resources
P.O. Box 10631
Jackson, MS 39289-0631
(601)961-5210
(601)354-6938 (fax)

For Office Use Only:

Aquifer: _____
Well #: E-183
L. S. Elevation: _____
E-log #: _____

County: WASHINGTON
Permit #: GW42137
Driller: J. NEWCOME 0-773
Date drilling completed: 8-14-07

State Law requires that this report be prepared by the driller in detail and filed with the Department within 30 days of completion of drilling of the well.

Well Owner Information	Well Location
Owner Name: <u>MONSANTO LELAND</u> <u>AG CENTER</u>	Latitude: <u>33° 25' 25"</u> Longitude: <u>90° 57' 05"</u>
Mailing Address: <u>PO Box 388</u> <u>STONE VILLS, MS. 38716</u> City State Zip Code	Method of Lat/Long (circle one): Conventional Survey, USGS quad. <u>(Hand-held GPS)</u> , Survey-grade GPS
Telephone: <u>662-820-0472</u>	SE 1/4 <u>NAT</u> 1/4 Sec. <u>8</u> Twn <u>18N</u> Rng <u>7W</u> <u>SW SW</u> Distance Direction Nearest Town <u>3</u> Miles <u>W</u> of <u>LELAND</u>

Well Data

Purpose of Well (circle one) Home Industrial Public Supply Irrigation Fish Culture Other: _____

Date well drilling started: 8-14-07 Date well drilling completed: 8-14-07

If flowing, method of flow regulation: Valve _____ Other (describe) _____

Static Water Level: _____ feet above or below (circle one) land surface Date measured: _____

Method of Measurement (circle one) steel tape electric tape air line other: _____

Hole depth: 93 Well depth: 90 Well grouted to a depth of 10

Type of grout (circle one): Cement Bentonite Mix

Casing length: 65 feet Casing diameter: 16 inches Type of casing: PUC

Screen length: 25 feet Screen diameter: 16 inches Type of screen: PUC

Screen slot size: .050 inches Setting depth: From 65 feet to 90 feet

Type of completion (circle all applicable): Gravel packed Underreamed Telescoped Open hole Natural Development

Other (describe): _____

Top of lap pipe or reduction in casing: _____ feet. If telescoped or more than one screen, describe on back of page

Logs run (circle all applicable): No log run Electric Gamma Ray Density Sonic Neutron Other: _____

Name of organization running log(s): _____

I certify that the well was drilled, constructed, and completed in accordance with all applicable requirements of the Mississippi Department of Environmental Quality and/or the Mississippi Department of Health regulations and state laws.

Department of Environmental Quality and/or the Mississippi Department of Health regulations and state laws.

JOHN NEWCOME 0-773


[Signature]
Signature of Water Well Contractor

Print Name of Water Well Contractor and License No.

RECEIVED
SEP 17 2007
BY: OLWR

If well telescopes please sketch below and show depths.


Ground Level

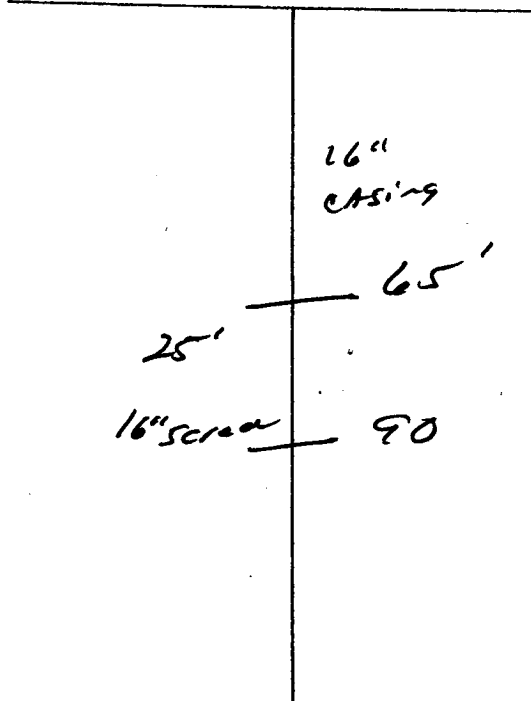

Description of Formations Encountered	From	To
TOP SOIL	0	10
MIX CLAY	10	40
FINE SAND	40	65
COARSE SAND	65	88
GRAY CLAY	88	93

If more than one screen, show location of each on sketch

Sketch the property layout and include the following: 1) the well location; 2) any permanent structures on the property that may aid in locating the well; 3) any roads, power lines, or other items that may aid in locating the property and the well; 4) indicate direction.

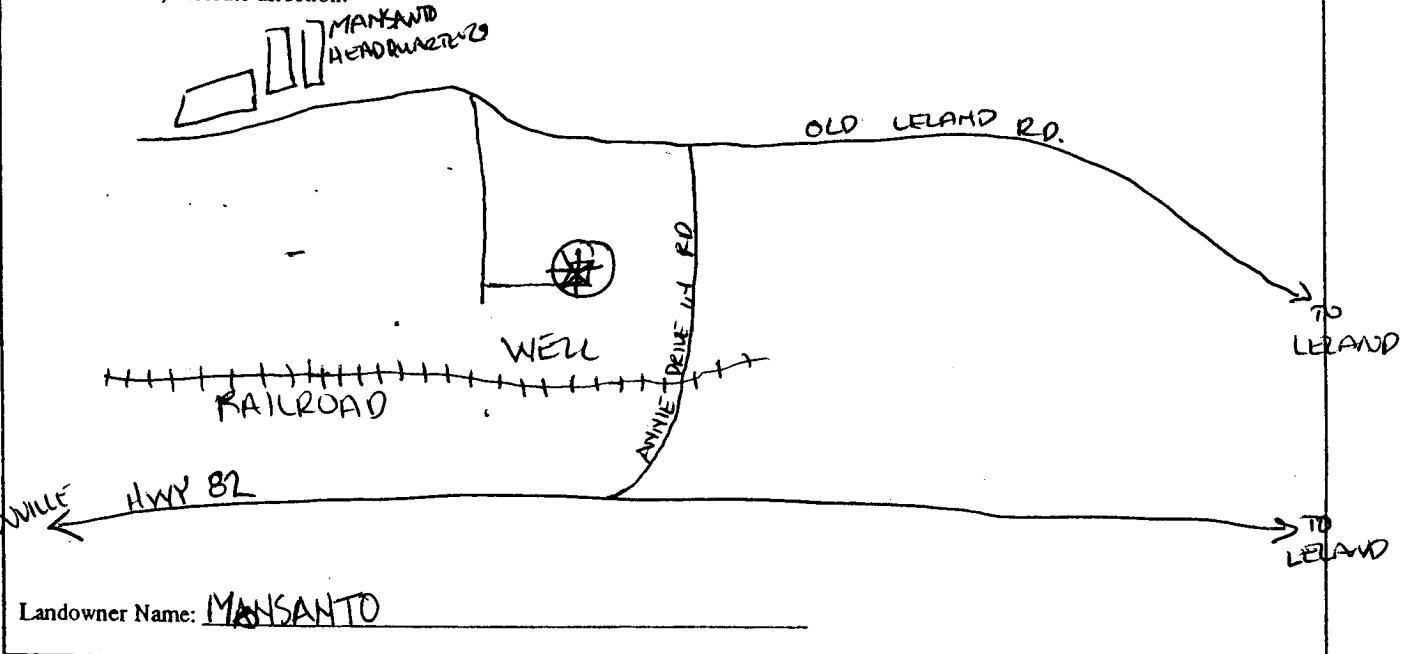

[Handwritten Signature]
 Signature of Water Well Contractor

Part 2

Pump Installer's Completion Report
 Mississippi Department of Environmental Quality
 Office of Land and Water Resources
 P.O. Box 10631
 Jackson, MS 39289-0631
 (601)961-5210
 (601)354-6938 (fax)

For Office Use Only:

Aquifer: _____

Well #: E-183

Elevation: _____

County: WASHINGTON
 Permit #: GW 42137
 Driller: J. NELSON 0-773
 Date completed: 8-14-07

This report should be prepared by the pump installer in detail and filed with the Department within 30 days of the installation of pump.

Well Owner Information	Well Location
Owner Name: <u>MONSANTO LELAND</u> <u>AG CENTER</u>	Latitude: <u>35-25-25</u> Longitude: <u>090-57-05</u>
Mailing Address: _____ <u>PO BOX 388</u> <u>STONEVILLE, MS. 38776</u>	Method of Lat/Long (circle one): Conventional Survey, USGS quad, Hand-held GPS, Survey-grade GPS
City: _____ State: _____ Zip Code: _____	<u>SE</u> ¼ <u>NW</u> ¼ Sec <u>8</u> Twn <u>18N</u> Rng <u>7W</u>
Telephone No. <u>662-820-0472</u>	Distance _____ Direction _____ Nearest Town _____ <u>3</u> Miles <u>W</u> of <u>LELAND</u>

Pump Type Circle one	Power Type Circle one
Air Lift: Jet <input type="checkbox"/> Submersible <input type="checkbox"/>	<u>Diesel Engine</u> Gasoline Engine Natural Gas
Bucket: Piston <input type="checkbox"/> <u>Turbine</u> <input checked="" type="checkbox"/>	Electric Motor Hand Tractor PTO
Centrifugal: Rotary <input type="checkbox"/> Flowing Well <input type="checkbox"/>	Windmill Other (specify): _____
Other (specify): _____	Horse Power Rating of Motor: <u>600</u>
Date Pump Installed: <u>8-20-07</u>	Setting Depth: <u>600</u> feet
Rated Pump Capacity: <u>3000</u> Gallons Per Minute	Number of Stages: <u>1</u>

RECEIVED
SEP 17 2007
BY: OLWR

Pump Test Data	Method of Measuring Water Level Circle one
Date Well Tested: _____	Air Line Electric Measuring Line Steel Tape
Static Water Level (A): _____ Feet Below Land Surface	Other (specify): _____
Pumping Water Level (B): <u>NO TEST</u> Feet Below Land Surface	For flowing well, measured shut in head: _____ feet
Drawdown [(B) - (A)]: _____ Feet Below Land Surface	Well yielded _____ GPM with a drawdown of _____ feet after _____ hours of pumping
Test Pumping Rate: _____ Gallons Per Minute	
Duration of Pump Test (minimum 4 hours): _____ hours	

I HEREBY CERTIFY that the above statements are true to the best of my knowledge.

GLEN ROWE #710-P
 Print Name of Pump Installer and License No. (if applicable)

Glen Rowe
 Signature of Pump Installer