
-			
	GTET		
		ell Report	For Office Use Only:
County: WASHING TON		art 1 t of Environmental Quality	Aquifer: <u>E 199</u>
Permit #: 60 44155	Office of Land a	nd Water Resources	Well #:
Driller: J. NEWCOME 0-773	P.O. E	lox 10631	
Date drilling completed: 4-30 -10		IS 39289-0631 961-5210	L. S. Elevation:
Date drilling completed:		4-6938 (fax)	E-log #:
State Law requires that this rep 30 days of completion of drilling	oort be prepared by the	driller in detail and filed v	with the Department within
Well Owner Inform		We	ll Location
Owner Name GT & T Farms		Latitude: 33 . 23 3	<u>5" Longitude: 90 ° 54 ' 41"</u>
Mailing Address: 1844 Jacqu	ueline Dr	Method of Lat/Long (circle o	
			d GPS) Survey-grade GPS
Greenville	MS 38701 tate Zip Code	<u>SW 14 NE 14 Sec 20</u>	<u>Twn 181 Rng 711</u>
City S	-	Distance Direction	
		Data	
Purpose of Well (circle one) Home I	ndustrial Public Supply	Irrigation Fish Culture	Other:
Date well drilling started: 4-30)-10 Date	well drilling completed:	-30-10
		•	
If flowing, method of flow regulation: V			
Static Water Level:feet	above or below (circle one)) land surface Date measured	f:
Method of Measurement (circle one)	steel tape electric tap	e air line other:	
Hole depth: <u>97</u> Well	- /		ffeet
	(Bentonite) Mit	v	
Type of grout (circle one): Cement	i Bentonile i IVII.	^	
Type of grout (circle one): Cement			PVC
Casing length: <u>55</u> feet Ca	asing diameter: 16	inches Type of casing	^
	asing diameter: 16	inches Type of casing	^
Casing length: <u>55</u> feet Ca Screen length: <u>40</u> feet S	asing diameter: 16 creen diameter: 16	inches Type of casing inches Type of screen:	Prc
Casing length: <u>55</u> feet Ca	asing diameter: <u>16</u> creen diameter: <u>16</u> es Setting depth: From	inches Type of casing inches Type of screen: feet to	PVC 75feet
Casing length: <u>55</u> feet Ca Screen length: <u>40</u> feet S Screen slot size: <u>050</u> inche	asing diameter: <u>16</u> creen diameter: <u>16</u> es Setting depth: From te): Gravel packed Und	inches Type of casing inches Type of screen: feet to	Pvc <u>75</u> feet ben hole Natural Development
Casing length: <u>55</u> feet Ca Screen length: <u>40</u> feet S Screen slot size: <u>050</u> inche	asing diameter: <u>16</u> creen diameter: <u>16</u> es Setting depth: From le): Gravel packed Und Other (describe): <u></u>	inches Type of casing inches Type of screen: fcet to lerreamed Telescoped Of	Pvc <u>75</u> feet ben hole Natural Development
Casing length:feet Ca Screen length:feet S Screen slot size:SOinche Type of completion (circle all applicable Top of lap pipe or reduction in casing: Logs run (circle all applicable) No log	asing diameter: 16 creen diameter: 16 es Setting depth: From le): Gravel packed Und Other (describe): feet. If grun Electric Gamma R	inches Type of casing inches Type of screen: fcet to derreamed Telescoped Op telescoped or more than one	Pvc <u>75</u> feet ben hole Natural Development screen, describe on back of page
Casing length:feet Ca Screen length:feet S Screen slot size:feet S Screen slot size:forinche Type of completion (circle all applicable Top of lap pipe or reduction in casing: Logs run (circle all applicable) No log Name of organization running log(s):	asing diameter: 16 creen diameter: 16 es Setting depth: From le): Gravel packed Und Other (describe): feet. If grun Electric Gamma R	inches Type of casing inches Type of screen: fcet to derreamed Telescoped Op telescoped or more than one ay Density Sonic Neutron	Prc Z5 feet Den hole Natural Development screen, describe on back of page a Other:
Casing length:feet Ca Screen length:feet S Screen slot size:inche Type of completion (circle all applicable Top of lap pipe or reduction in casing: Logs run (circle all applicable) No log Name of organization running log(s): I certify that the well was drilled, com	asing diameter: 16 creen diameter: 16 es Setting depth: From le): Gravel packed Und Other (describe): feet. If grun Electric Gamma R	inches Type of casing inches Type of screen: fcet to lerreamed Telescoped Op telescoped or more than one ay Density Sonic Neutron n accordance with all applica	Prc 75 feet pen hole Natural Development screen, describe on back of page a Other: ble requirements of the Mississippi
Casing length:feet Ca Screen length:feet S Screen slot size:feet S Screen slot size:forinche Type of completion (circle all applicable Top of lap pipe or reduction in casing: Logs run (circle all applicable) No log Name of organization running log(s):	asing diameter: 16 creen diameter: 16 es Setting depth: From le): Gravel packed Und Other (describe): feet. If grun Electric Gamma R	inches Type of casing inches Type of screen: fcet to lerreamed Telescoped Op telescoped or more than one ay Density Sonic Neutron n accordance with all applica	Prc 75 feet pen hole Natural Development screen, describe on back of page a Other: ble requirements of the Mississippi
Casing length:feet Ca Screen length:feet S Screen slot size:inche Type of completion (circle all applicable Top of lap pipe or reduction in casing: Logs run (circle all applicable) No log Name of organization running log(s): I certify that the well was drilled, com	asing diameter: 16 creen diameter: 16 es Setting depth: From le): Gravel packed Und Other (describe): feet. If grun Electric Gamma R	inches Type of casing inches Type of screen: fcet to lerreamed Telescoped Op telescoped or more than one ay Density Sonic Neutron n accordance with all applica	Prc 75 feet pen hole Natural Development screen, describe on back of page a Other: ble requirements of the Mississippi

AUG 1 6 2010 BY: OLW If well telescopes please sketch below and show depths.

Ground Level

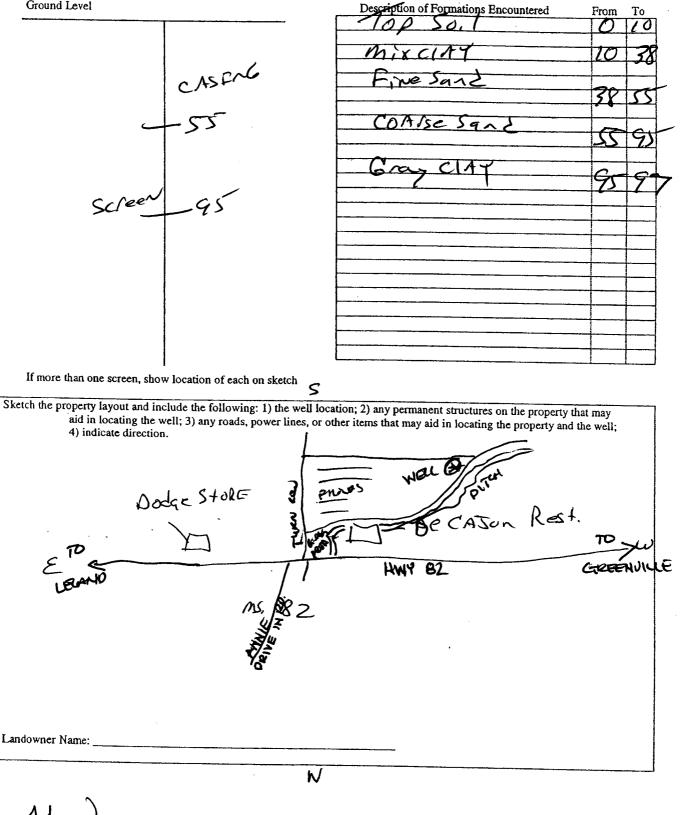

Signature of Water Well Contractor

STATI	E WELL REPORT		
Mississippi De	Part 2 staller's Completion Report partment of Environmental Quality	For Office Use Only: Aquifer:	
Drillered. New come 0-773	f Land and Water Resources P.O. Box 10631	Aquirer: <u>E199</u> Well#:	
Date completed: 4-30-10	ckson, MS 39289-0631 (601)961-5210 (601)354-6938 (fax)	Elevation:	
This report should be prepared by the pump installer installation of pump.		ent within 30 days of the	
Well-Owner Information	1	Il Location	
Owner Name: GT+T Farms	Latitude: 33°23'35	"Longitude: 090° 56'41"	
Mailing Address: 1844 Jacqueline Dr	Method of Lat/Long (circle o		
	USGS quad, Han	USGS quad, Hand-held GPS Survey-grade GPS SW 14 NE 14 Sec 20 Twn 18 Rng 7W	
Greenville, MS 3870	<u>I SW 14 NE 14 Sec 2</u>		
	Distance Direction	1	
Telephone No. ()	2.5 Miles E	of Leland	
Ршир Туре	P	ower Type	
Circle one Air Lift Jet Submersible		Circle one line Engine Natural Gas	
Bucket Piston Turbine	Electric Motor Hand		
Centrifugal Rotary Flowing Well		r (specify):	
Other (specify):	Horse Power Rating of Moto	or:	
Date Pump Installed: 4130/10	Setting Depth:	feet	
Rated Pump Capacity: 2800 Gallons Per Min	nute Number of Stages:	<u> </u>	
Pump Test Data		leasuring Water Level Circle one	
Date Well Tested:		easuring Line Steel Tape	
Static Water Level (A):Feet Below Land Sur	rface Other (specify):		
Pumping Water Level (B):Feet Below Land Sur	face		
Drawdown [(B) - (A)]:Feet Below Land Sur	rface For flowing well, measured	shut in head:feet	
Test Pumping Rate:Gallons Per Mi	nute ~ Well yielded	GPM with a drawdown of	
Duration of Pump Test (minimum 4 hours):h	oursfeet after	bours of pumping	
I HEREBY CERTIFY that the above statements are true to	the best of my knowledge		
Cong Rowe 0-71	P	au _	
Print Name of Pump Installer and License No. (if applicable	e) Signature of Pump	Installer	
		AUG 1 6 2010	
		BA.OM	