

Washington  
E 1001  
5-13-80

MISSISSIPPI  
BOARD OF WATER COMMISSIONERS  
416 North State Street  
Jackson, Mississippi 39201

WATER WELL DRILLERS LOG

April 1 1980 Larry's Well & Pump Washington  
date well completed firm name county well located

LANDOWNER:	description of formations encountered	from	to
Bill Hamilton	clay	0'	17'
LeLand, MS	fine sand	17'	33'
(mailing address)	med sand	33'	40'
WELL LOCATION:	coarse sand	40'	75'
sec. 28 T 18 N R 7 E	coarse sand & siltstone	75'	106'
1 1/2 miles S of LeLand			
(distance) (direction) (nearest town)			
WELL PURPOSE: Irrigation			
(home, irrigation, municipal, industrial)			
WELL COMPLETION DATA:			
(1) diameter (inches) 16"			
(2) total depth (feet) 106'			
(3) static water level (feet) 20' <sup>below</sup> above top of ground.			
(4) casing steel, 66' (material) (depth)			
(size) if telescope see back.			
(5) screen 40' 66' (length) (depth to top)			
16" steel (size) (material)			
(6) pump 60 3000 (HP) (yield gpm)			
(type power)			
(7) electric log No (yes or no)			
(organization running log)			
(8) how well bottom plugged steel plate			
DRILLERS REMARKS:			

DEPT OF NATURAL RESOURCES  
BUREAU OF LAND & WATER RESOURCES


MAY 12 1980

RECEIVED

If well telescopes please sketch and show depths.

GROUND LEVEL

N

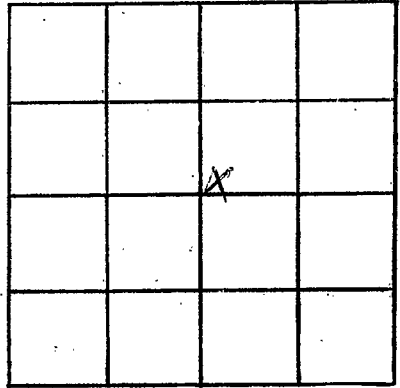

SECTION 28

Please indicate well location X.

ADDITIONAL INFORMATION

If more than one screen, show locations of each on sketch.