

MISSISSIPPI DEPARTMENT OF NATURAL RESOURCES

Bureau of Land and Water Resources

Southport Mall

P.O. Box 10631

Jackson, Mississippi 39209

WATER WELL DRILLERS LOG

CODED

Washington
E B 47 1041
7/19/82

? Belong in E

9 July 1982 Coppase Drilling Inc Washington
 date well completed firm name county well located

LANDOWNER: Miss. State. Univ.
MAFEES
Stoneville, MS
 (mailing address)

description of formations encountered	from	to
Clay	0	15
Sand & Clay	15	20
Sand	20	65
Gravel	65	100
	100	-

WELL LOCATION:
 sec 4 1/2 T 18 N R 7
1 1/2 miles North of Stoneville
 (distance) (direction) (nearest town)

WELL PURPOSE: Center Pivotal
 (home, irrigation, municipal, industrial)

- WELL COMPLETION DATA:
- (1) diameter (inches) 26"
 - (2) total depth (feet) 100'
 - (3) static water level (feet) 28 below top of ground.
 - (4) casing Steel, 40' (material) (depth)
12" (size) If telescope see back.
 - (5) screen 60', 40' (length) (depth to top)
12", Steel 17% Horiz. (size) (material)
 - (6) pump 60 800 (HP) (yield gpm)
Diesel (type power)
 - (7) electric log no (yes or no)
 - (organization running log)
 - (8) how well bottom plugged Plata

CODED

DEPT. OF NATURAL RESOURCES
 BUREAU OF LAND & WATER RESOURCES


JUL 30 1982

RECEIVED

DRILLERS REMARKS: Pump set
50' w/ 20' Tail pipe

If well telescopes please sketch and show depths.

GROUND LEVEL

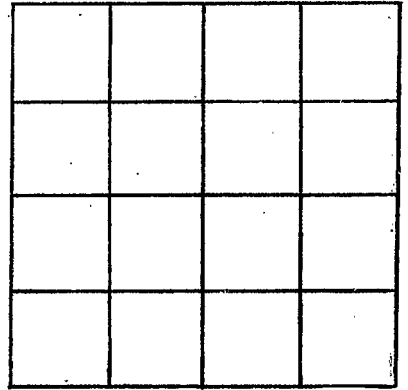

SECTION _____

Please indicate well location X.

ADDITIONAL INFORMATION

If more than one screen,
show locations of each on sketch.