

WASHINGTON  
E 2001  
8-16-77

MISSISSIPPI  
BOARD OF WATER COMMISSIONERS  
416 North State Street  
Jackson, Mississippi 39201

WATER WELL DRILLERS LOG

8-16 1977 Bailey Drilling Washington  
date well completed firm name county well located

LANDOWNER: Earl Allen  
Leland, Miss.

description of formations encountered	from	to
	Clay	0
Sand	15	55
Gravel	55	69

(mailing address)

WELL LOCATION:

sec. 18 T 18 N R 7 E  
S W  
4 miles E of Greenville  
(distance) (direction) (nearest town)

WELL PURPOSE: Nursery  
(home, irrigation, municipal, industrial)

WELL COMPLETION DATA:

- (1) diameter (inches) 2"
- (2) total depth (feet) 69
- (3) static water level (feet) 15 below top of ground.
- (4) casing Steel, 63' (material) (depth)  
2" (size) if telescope see back.
- (5) screen 6' 63' (length) (depth to top)  
2 1/2" Stainless Steel (size) (material)
- (6) pump 1 1/2 HP 25 (yield gpm)  
Electric (type power)
- (7) electric log No (yes or no)

(organization running log)


(8) how well bottom plugged  
Back pressure valve

DRILLERS REMARKS:

RECEIVED  
AUG 28 1977  
WATER BOARD

If well telescopes please sketch and show depths.

GROUND LEVEL

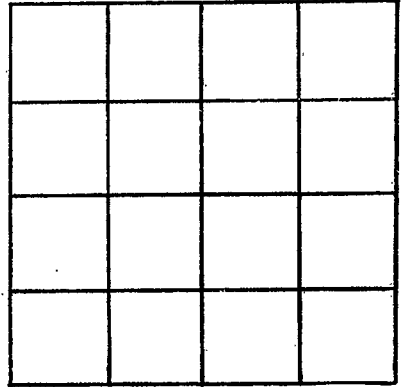

SECTION \_\_\_\_\_

Please indicate well location X.

ADDITIONAL INFORMATION

If more than one screen,  
show locations of each on sketch.