

WASHINGTON

E 2000

5-2-77

MISSISSIPPI BOARD OF WATER COMMISSIONERS  
416 North State Street  
Jackson, Mississippi 39201

WATER WELL DRILLERS LOG

5-2  
date well completed

151 27 Schulz Drilling  
firm name

Washington  
county well located

LANDOWNER: Rondie Lucius

description of formations encountered

from to

Leland MS  
(mailing address)

clay

0 20

sand

20 105

WELL LOCATION:

sec. 219 T. 18 N R. 2 E  
4 miles W of Leland  
(distance) (direction) (nearest town)

clay

105 145

sand, clay

145 180

WELL PURPOSE: Home  
(home, irrigation, municipal, industrial)

sand, shale

180 340

WELL COMPLETION DATA:

sand

FINE

340 470

(1) diameter (inches) 2"

sand

bed

470 480

(2) total depth (feet) 480

(3) static water level (feet) 42 below above top of ground.

(4) casing P.V.C.  
(material) (depth)

(size) if telescope see back.

(5) screen 10  
(length) (depth to top)

2" P.V.C.  
(size) (material)

(6) pump 1 10  
(HP) (yield gpm)

(type power)

(7) electric log (yes or no)

(organization running log)

(8) how well bottom plugged flush


DRILLERS REMARKS:

RECEIVED  
JUN 8 1977

MISS. Bd. OF WATER COMMISSIONERS

If well telescopes please sketch and show depths.

GROUND LEVEL

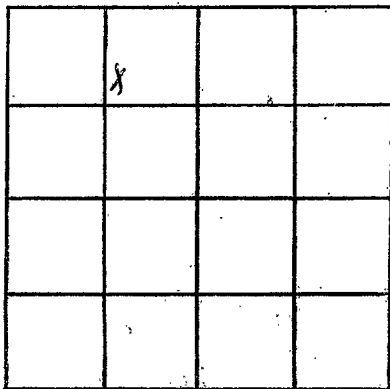

SECTION 19

Please indicate well location X.

ADDITIONAL INFORMATION

Lined area for additional information.

If more than one screen, show locations of each on sketch.