

Washington
 E 2003
 7/15/77

MISSISSIPPI
 BOARD OF WATER COMMISSIONERS
 416 North State Street
 Jackson, Mississippi 39201

WATER WELL DRILLERS LOG

July 15, 1977 Schultz Drilling Co Washington
 date well completed firm name county well located

LANDOWNER: E. Gambell
 Leland
 (mailing address)
 WELL LOCATION:
 sec. 31 T. 18N R. 7E
 S W
 5 miles West of Leland
 (distance) (direction) (nearest town)

description of formations encountered	from	to
Clay	0	20
Sand	20	120
SANDY Shale	120	160
Shale	160	300
SAND	300	360

WELL PURPOSE: home
 (home, irrigation, municipal, industrial)


- WELL COMPLETION DATA:
- (1) diameter (inches) 2 in
 - (2) total depth (feet) 360 ft
 - (3) static water level (feet) 20 below above top of ground.
 - (4) casing PVC, 340 ft
 (material) (depth)
 (size) if telescope see back.
 - (5) screen 20 ft, 340
 (length) (depth to top)
2 PVC
 (size) (material)
 - (6) pump 1 8
 (HP) (yield gpm)
220
 (type power)
 - (7) electric log NO
 (yes or no)
 (organization running log)
 - (8) how well bottom plugged b/w

DRILLERS REMARKS:

YIELD
 NOV 30 1977
 MISS. BD. OF WATER COMM.

If well telescopes please sketch and show depths.

GROUND LEVEL

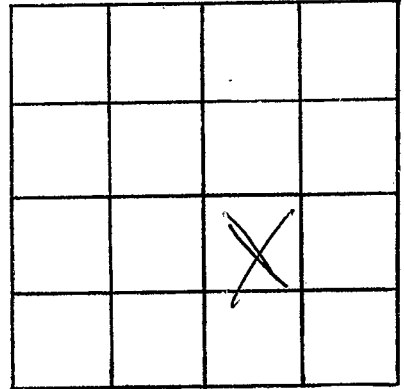

SECTION 31

Please indicate well location X.

ADDITIONAL INFORMATION

If more than one screen,
show locations of each on sketch.