

Washington
E 2004
4-12-77

MISSISSIPPI
BOARD OF WATER COMMISSIONERS
416 North State Street
Jackson, Mississippi 39201

WATER WELL DRILLERS LOG

~~4/12/77~~ 12 APR 1977 Lambert Dr. N. Wash
date well completed firm name county well located

LANDOWNER:
R. L. Graham
Greenville, Miss.
(mailing address)

WELL LOCATION:
sec. 19 T 18 N R 7 E W
5 3/4 miles E of Greenville
(distance) (direction) (nearest town)

WELL PURPOSE: none
(home, irrigation, municipal, industrial)

- WELL COMPLETION DATA:
- (1) diameter (inches) 2
 - (2) total depth (feet) 500
 - (3) static water level (feet) 46 below top of ground.
 - (4) casing PVC 490 (material) (depth)
(size) if telescope see back.
 - (5) screen 10 500-490 (length) (depth to top)
2 PVC (size) (material)
 - (6) pump 1 10 (HP) (yield gpm)
Elect (type power)
 - (7) electric log (yes or no)
 - (organization running log)
 - (8) how well bottom plugged back wash

description of formations encountered	from	to
Mixed	0	20
Sand	20	60
Sand & gravel	60	105
blow shell	105	145
Clay	145	180
Clay & sand	180	340
tight sand	340	420
Sand med.	420	460
Sand, good	460	500


RECEIVED
JUN 29 1977

MISS. BD. OF WATER COMMISSIONERS

DRILLERS REMARKS:

If well telescopes please sketch and show depths.

GROUND LEVEL

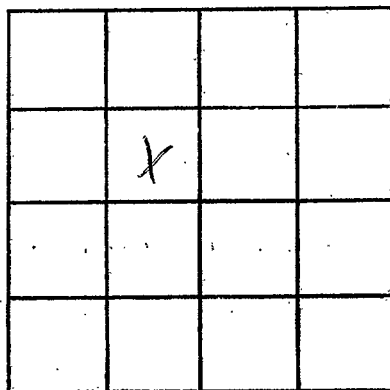

SECTION 19.

Please indicate well location X.

ADDITIONAL INFORMATION

If more than one screen,
show locations of each on sketch.