

Washington
 E 2005
 9/6/77

MISSISSIPPI
 BOARD OF WATER COMMISSIONERS
 416 North State Street
 Jackson, Mississippi 39201

WATER WELL DRILLERS LOG

6 Sept 1977 Lambert Drilling Wash
 date well completed firm name county well located


LANDOWNER:	description of formations encountered	from	to
J. McCoy Greenwood, Miss. (mailing address)			
WELL LOCATION:	sand	15	60
sec. 19 T. 15 N. R. 2 E 5 miles E of Greenwood (distance) (direction) (nearest town)	Sand, gravel	60	80
WELL PURPOSE: none (home, irrigation, municipal, industrial)	blue shell	80	160
WELL COMPLETION DATA:	Clay & Sand	160	300
(1) diameter (inches) 2	Sand & Clay st	300	345
(2) total depth (feet) 450	Sand, light	345	370
(3) static water level (feet) 36 below top of ground.	Sand, med.	370	395
(4) casing PVC 440 (material) (depth)	Sand, gravel	395	450
(size) If telescope see back.			
(5) screen 10 450-440 (length) (depth to top)			
2" PVC (size) (material)			
(6) pump 1 10 (HP) (yield gpm)			
elect (type power)			
(7) electric log <input checked="" type="checkbox"/> (yes or no)			
(organization running log)			
(8) how well bottom plugged back wash			
DRILLERS REMARKS:			

RECEIVED
 DEC 9 1977

MISS. BD. OF WATER COMMISSIONERS

If well telescopes please sketch and show depths.

GROUND LEVEL

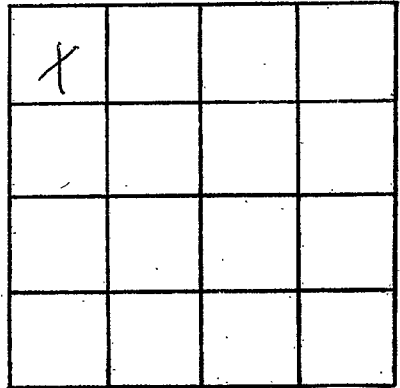

SECTION 19

Please indicate well location X.

ADDITIONAL INFORMATION

If more than one screen,
show locations of each on sketch.