

Washington  
E 2000

MISSISSIPPI  
BOARD OF WATER COMMISSIONERS  
416 North State Street  
Jackson, Mississippi 39201

12/19/78

WATER WELL DRILLERS LOG

9 Dec 1978 date well completed  
Lambert Drilling firm name  
Wash county well located

LANDOWNER:	description of formations encountered	from	to
(mailing address)			
Tom Mervett Heland, Miss.	Mixed	0	30
WELL LOCATION: sec 2 T 18 N R 2 E 1 miles S of Heland.	Sand	30	80
(distance) (direction) (nearest town)	Sand & gravel	80	135
WELL PURPOSE: none (home, irrigation, municipal, industrial)	Clay	105	290
WELL COMPLETION DATA: (1) diameter (inches) 2 X 4 (2) total depth (feet) 490 (3) static water level (feet) 25 below top of ground. (4) casing PVC, 470 (material) (depth) 4 X 2 (size) if telescope see back. (5) screen 20, 490-470 (length) (depth to top) 2" (size), PVC (material) (6) pump 1 (HP), 20 (yield gpm) split (type power) (7) electric log no (yes or no)	Clay & sand	290	420
(organization running log)	Sand med.	420	430
(8) how well bottom plugged: back dress.	Sand, gravel	430	500
DRILLERS REMARKS:			

Miss. Board of Water Comm.

APR 4 - 1979

RECEIVED


If well telescopes please sketch and show depths.

GROUND LEVEL

4" — 140

2" — 470

2" screen 490

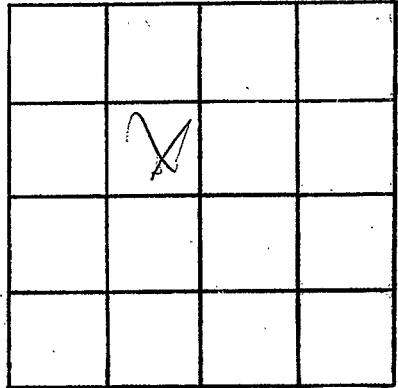

SECTION 2

Please indicate well location X.

ADDITIONAL INFORMATION

If more than one screen, show locations of each on sketch.