


WASHINGTON
 E 2007
 7-25578

MISSISSIPPI
 BOARD OF WATER COMMISSIONERS
 416 North State Street
 Jackson, Mississippi 39201

WATER WELL DRILLERS LOG

25 July 1978 date well completed
 Lambert Drilling West firm name
 West county well located

LANDOWNER:	description of formations encountered	from	to
Allan Estate Heland, Miss. (mailing address)	Mixed.	0	15
WELL LOCATION: sec. 34 T 18 N R 7 E 3 miles S of Heland (distance) (direction) (nearest town)	Clay	15	30
WELL PURPOSE: home (home, irrigation, municipal, industrial)	Sand.	30	80
WELL COMPLETION DATA: (1) diameter (inches) 4x2 (2) total depth (feet) 450 (3) static water level (feet) 18 below top of ground. (4) casing PVC, 430 (material) (depth) 4x2 (size) if telescope see back. (5) screen 20, 450-430 (length) (depth to top) 2, PVC (size) (material) (6) pump 1, 20 (HP) (yield gpm) elect (type power) (7) electric log no (yes or no) (organization running log) (8) how well bottom plugged back press.	Sand & gravel	80	130
	Clay	130	210
	Clay st Sand	210	290
	Sand st Clay	290	390
	Sand	390	450
DRILLERS REMARKS:			

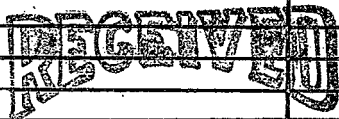

SEP - 8 1978


If well telescopes please sketch and show depths.

GROUND LEVEL

140 4"

430 2"

450 2" screen

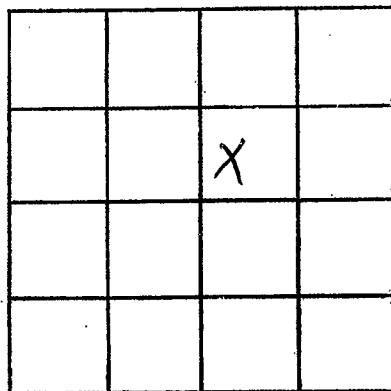

SECTION 34

Please indicate well location X.

ADDITIONAL INFORMATION

If more than one screen, show locations of each on sketch.