

WASHINGTON

E 2009

6/26/78

MISSISSIPPI BOARD OF WATER COMMISSIONERS
416 North State Street
Jackson, Mississippi 39201

WATER WELL DRILLERS LOG

6-26-1978 Briley Drilling Co Washington
date well completed firm name county well located

LANDOWNER: E E Cooper
Leland, Miss

description of formations encountered

from to

Clay	0	28
Sand	28	64
Gravel	64	169
Mud	169	315
Sand	315	452

(mailing address)

WELL LOCATION:

sec 34 T 18 N R 7 E
3 miles S of Leland
(distance) (direction) (nearest town)

WELL PURPOSE: Home
(home, irrigation, municipal, industrial)

WELL COMPLETION DATA:

- (1) diameter (inches) 4 X 2
- (2) total depth (feet) 452
- (3) static water level (feet) 33 below above top of ground.
- (4) casing Steel, 436,
(material) (depth)
4 X 2 If telescope see back.
(size)
- (5) screen 16 ft,
(length) (depth to top)
2", Stainless Steel
(size) (material)
- (6) pump 1 19
(HP) (yield gpm)
Electric
(type power)
- (7) electric log No
(yes or no)

(organization running log)


(8) how well bottom plugged
Back pressure valve

DRILLERS REMARKS:

REGISTERED
JUL 15 1978
MISS. Bd. OF WATER COMMISSIONERS

If well telescopes please sketch and show depths.

GROUND LEVEL

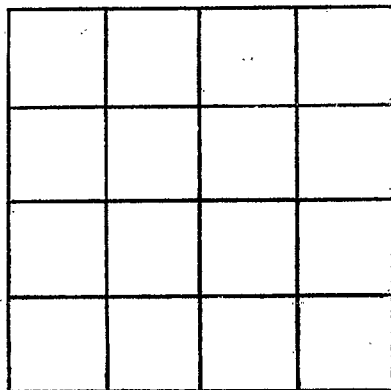

SECTION _____

Please indicate well location X.

ADDITIONAL INFORMATION

If more than one screen,
show locations of each on sketch.