

Washington
E 2010

MISSISSIPPI
BOARD OF WATER COMMISSIONERS
416 North State Street
Jackson, Mississippi 39201

7-18-79

WATER WELL DRILLERS LOG

July 18 1979
date well completed

Schultz Drilling
firm name

Washington
county well located

LANDOWNER: Ronnie LULIUS

Leland MS
(mailing address)

description of formations encountered	from	to
CLAY	0	20
SAND	20	105
CLAY	105	145
SAND & SHALE	145	340
SAND FINE	340	470
SAND	470	480

WELL LOCATION:
sec. 19 T. 18 N. R. 7 E.
4 miles S W of Leland
(distance) (direction) (nearest town)

WELL PURPOSE: HOME
(home, irrigation, municipal, industrial)


- WELL COMPLETION DATA:
- (1) diameter (inches) 2 1/2
 - (2) total depth (feet) 480
 - (3) static water level (feet) 42 below above top of ground.
 - (4) casing PVC (material) (depth) _____
(size) if telescope see back.
 - (5) screen 10 470'
(length) (depth to top)
2 1/2" PVC
(size) (material)
 - (6) pump 1 10
(HP) (yield gpm)
elo
(type power)
 - (7) electric log no
(yes or no)
 - (organization running log) _____
 - (8) how well bottom plugged B/w

new 4 1/2" casing

DRILLERS REMARKS:

If well telescopes please sketch and show depths.

GROUND LEVEL

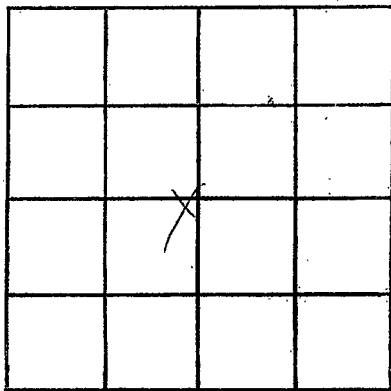

SECTION _____

Please indicate well location X.

ADDITIONAL INFORMATION

If more than one screen, show locations of each on sketch.