

WASHINGTON
E 2011
8-19-80

MISSISSIPPI
 BOARD OF WATER COMMISSIONERS
 416 North State Street
 Jackson, Mississippi 39201

WATER WELL DRILLERS LOG

19 Aug, 19 80 Lambert Drilling Wash
 date well completed firm name county well located

LANDOWNER:
Pioneer Seed Co.
Greenville, Miss.
 (mailing address)

WELL LOCATION:
 sec. 14 T. 18 N. R. 7 E
4 miles E of Greenville
 (distance) (direction) (nearest town)

WELL PURPOSE: irrigate
 (home, irrigation, municipal, industrial)

WELL COMPLETION DATA:

- (1) diameter (inches) 4 X 2
- (2) total depth (feet) 470
- (3) static water level (feet) 42 below above
top of ground.
- (4) casing PVC, 450,
(material) (depth)
4 1/2 if telescope see back.
(size)
- (5) screen 20, 450-470
(length) (depth to top)
2 1/2, SS
(size) (material)
- (6) pump 1 20
(HP) (yield gpm)
elect
(type power)
- (7) electric log _____
(yes or no)

(organization running log)
- (8) how well bottom plugged _____
back press.

description of formations encountered	from	to
<u>mixed</u>	<u>0</u>	<u>15</u>
<u>Sand</u>	<u>15</u>	<u>100</u>
<u>Red gravel</u>	<u>100</u>	<u>220</u>
<u>Clay</u>	<u>220</u>	<u>205</u>
<u>Clay & Sand</u>	<u>205</u>	<u>370</u>
<u>Sandy mol</u>	<u>370</u>	<u>405</u>
<u>Sand str.</u>	<u>405</u>	<u>440</u>
<u>Sand gravel</u>	<u>440</u>	<u>475</u>

DEPT. OF NATURAL RESOURCES
 BUREAU OF LAND & WATER RESOURCES
 DEC 15 1980
 RECEIVED


DRILLERS REMARKS:

If well telescopes please sketch and show depths.

GROUND LEVEL

140

4.11

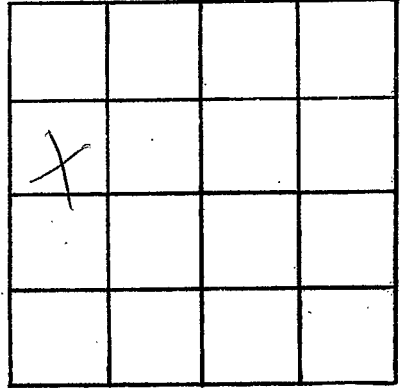

SECTION 19

Please indicate well location X.

ADDITIONAL INFORMATION

Lined area for additional information.

If more than one screen, show locations of each on sketch.

1450

2nd screen