

Wash.

MISSISSIPPI
 BOARD OF WATER COMMISSIONERS
 416 North State Street
 Jackson, Mississippi 39201

WATER WELL DRILLERS LOG

E 2012
 6-10-80

6/10 1980
 date well completed

Schultz Drilling Co.
 firm name

Wash.
 county well located

LANDOWNER: Don E. Theridge
St. Christopher Rd.
Leland MS.
 (mailing address)

description of formations encountered

from

to

WELL LOCATION:
 sec. 19 T. 18 (N) R. 7 E
5 miles (distance) NE (direction) of Leland (nearest town)

Clay	0	20
SAND	20	110
Clay	110	150
SANDY SHALE	150	350
SAND	350	420
GOOD SAND	420	470

WELL PURPOSE: Home
 (home, irrigation, municipal, industrial)

WELL COMPLETION DATA:

- (1) diameter (inches) 2"
- (2) total depth (feet) 470'
- (3) static water level (feet) 43' below above top of ground.
- (4) casing PVC 460
 (material) (depth)
- (size) if telescope see back.
- (5) screen 10' 460
 (length) (depth to top)
- 2" PVC
 (size) (material)
- (6) pump 1 10
 (HP) (yield gpm)
- ele
 (type power)
- (7) electric log NO
 (yes or no)

(organization running log)

(8) how well bottom plugged 1/2 W

DRILLERS REMARKS:


DEPT. OF NATURAL RESOURCES
 BUREAU OF LAND & WATER RESOURCES

JUL - 2 1980

RECEIVED

If well telescopes please sketch and show depths.

GROUND LEVEL

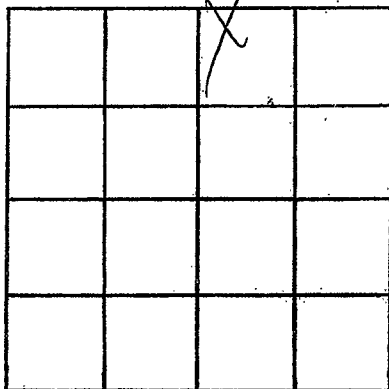

SECTION _____

Please indicate well location X.

ADDITIONAL INFORMATION

If more than one screen,
show locations of each on sketch.