

WASHINGTON

E-203

5-30-80

5-30

MISSISSIPPI  
 BOARD OF WATER COMMISSIONERS  
 416 North State Street  
 Jackson, Mississippi 39201

WATER WELL DRILLERS LOG

1980 Schultz Drilling Co Washington  
 firm name county well located

LANDOWNER: E. JENNINGS

Hwy 82 E

Leland MS.  
 (mailing address)

description of formations encountered

from

to

Clay

0 20

SAND

20 109

WELL LOCATION:

sec. 17 T. 18 N. R. 7 E. W. 4  
 (distance) miles (direction) of Leland  
 (nearest town)

Clay

109 150

SANDY SHALE 150 350

WELL PURPOSE: FINE  
 (home, irrigation, municipal, industrial)

Fine to Med SAND 350 420

GOOD SAND 420 480

WELL COMPLETION DATA:

- (1) diameter (inches) 4x2
- (2) total depth (feet) 480
- (3) static water level (feet) 43 below top of ground.
- (4) casing PVC 460 (material) (depth)
- 4x2 (size) If telescope see back.
- (5) screen 20' 460 (length) (depth to top)
- 2" PVC (size) (material)
- (6) pump 1 20 (HP) (yield gpm)
- ele (type power)
- (7) electric log NO (yes or no)

(organization running log)

(8) how well bottom plugged b/w



DEPT. OF NATURAL RESOURCES  
 BUREAU OF LAND & WATER RESOURCES

JUL - 2 1980

DRILLERS REMARKS:

RECEIVED

If well telescopes please sketch and show depths.

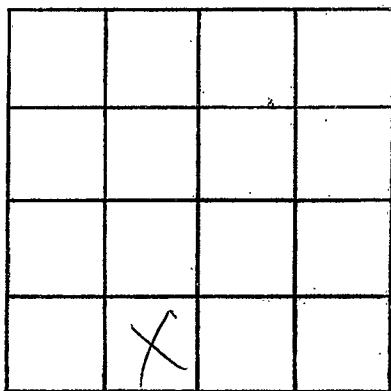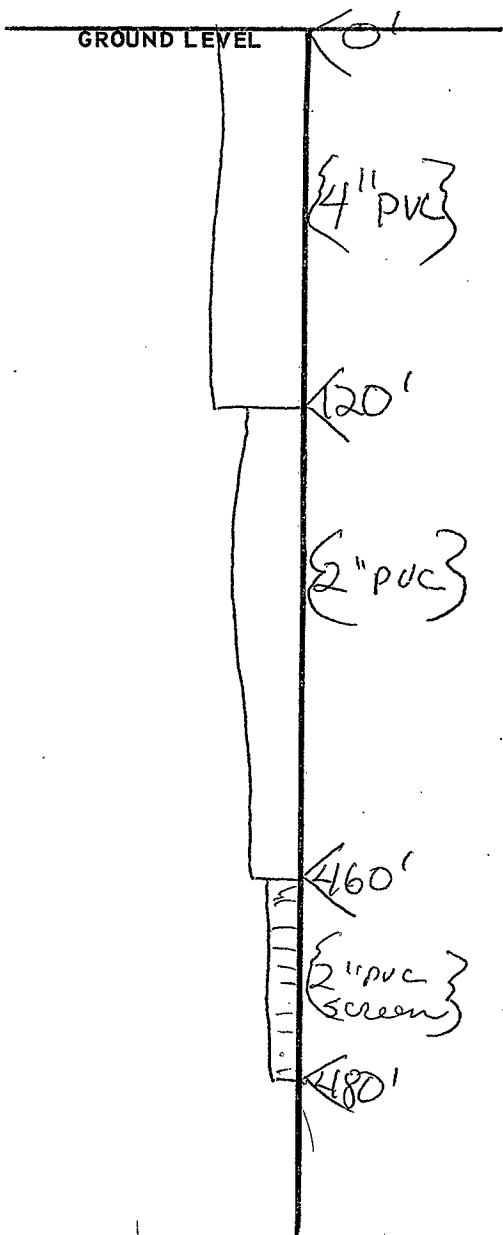

SECTION \_\_\_\_\_

Please indicate well location X.

ADDITIONAL INFORMATION

A series of horizontal lines for additional information.

If more than one screen, show locations of each on sketch.