


If well telescopes please sketch and show depths.

GROUND LEVEL

~~140~~ 411

~~400~~ 211

~~420~~ 211 05.

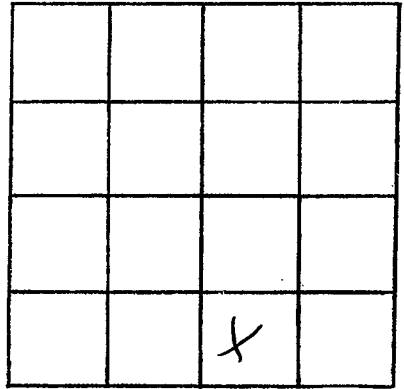

SECTION 20

Please indicate well location X.

ADDITIONAL INFORMATION

If more than one screen,
show locations of each on sketch.