

MISSISSIPPI DEPARTMENT OF NATURAL RESOURCES

Bureau of Land and Water Resources

Southport Mall

P.O. Box 10631

Jackson, Mississippi 39209

WATER WELL DRILLERS LOG

WASHINGTON
E 2015
7-10-81

10 July 1981 date well completed
Lambert Drilling West firm name
Lesh county well located

LANDOWNER:	description of formations encountered	from	to
WELL LOCATION:			
Walter Swain Leland, MISS. (mailing address)	Mixed	0	10
sec. 19 T 18 N R 7 E K miles E W of Leland (distance) (direction) (nearest town)	Sand	10	50
WELL PURPOSE: Home (home, irrigation, municipal, industrial)	Gravel	50	106
WELL COMPLETION DATA:	Clay	106	205
(1) diameter (inches) 4 1/2	Clay & sand	205	230
(2) total depth (feet) 380	Sand, grav.	230	380
(3) static water level (feet) 32 below top of ground.			
(4) casing PVC, 360 (material) (depth) 4 1/2 (size) if telescope see back.			
(5) screen 20, 380-360 (length) (depth to top) 2" PVC (size) (material)			
(6) pump 1 1/2 HP, 28 (HP) (yield gpm) Electric (type power)			
(7) electric log no (yes or no) (organization running log)			
(8) how well bottom plugged Back Pass.			

DEPT. OF NATURAL RESOURCES
BUREAU OF LAND & WATER RESOURCES

SEP 16 1981

RECEIVED

DRILLERS REMARKS:

If well telescopes please sketch and show depths.

GROUND LEVEL

140


411

360

211

380

211 SCV

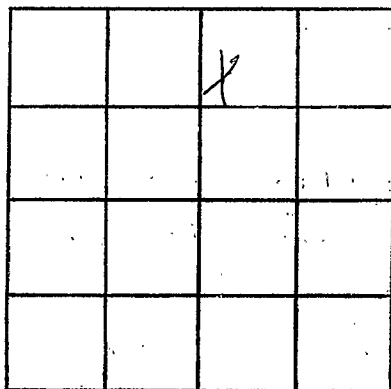

SECTION 19

Please indicate well location X.

ADDITIONAL INFORMATION

If more than one screen,
show locations of each on sketch.