

MISSISSIPPI DEPARTMENT OF NATURAL RESOURCES

Bureau of Land and Water Resources

Southport Mall

P.O. Box 10631

Jackson, Mississippi 39209

WATER WELL DRILLERS LOG

Washington
E 2010

4-16

1982

Schultz Drilling

Washington

date well completed

firm name

county well located

LANDOWNER:

USPSA

Stoneville, MS

(mailing address)

WELL LOCATION:

sec. 2 T 18 N R 7 E
1 miles N of Stoneville

WELL PURPOSE: IRRIGATION
(home, irrigation, municipal, industrial)

WELL COMPLETION DATA:

- (1) diameter (inches) 2"
- (2) total depth (feet) 80'
- (3) static water level (feet) 15' below top of ground
- (4) casing PVC 70' (material), (depth)
- (5) screen 10' 70' (length), (depth to top)
2" PVC (size), (material)
- (6) pump X X (HP), (yield gpm)
X (type power)
- (7) electric log No (yes or no)
- (8) how well bottom plugged cap/pvc

description of formations encountered

from

to

SANDY TOPSOIL 0 15
SAND, pea gravel 15 80

DEPT. OF NATURAL RESOURCES
BUREAU OF LAND & WATER RESOURCES


MAY 14 1982

RECEIVED

DRILLERS REMARKS:

If well telescopes please sketch and show depths.

GROUND LEVEL

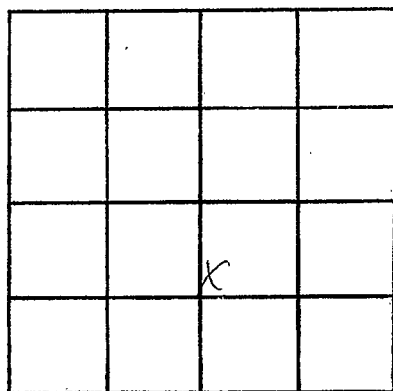

SECTION _____

Please indicate well location X.

ADDITIONAL INFORMATION

If more than one screen,
show locations of each on sketch.