

MISSISSIPPI DEPARTMENT OF NATURAL RESOURCES

Bureau of Land and Water Resources

Southport Mall

P.O. Box 10631

Jackson, Mississippi 39209

WATER WELL DRILLERS LOG

Washington
E
2017

4-16 1982 date well completed Schultz Drilling firm name Washington county well located

LANDOWNER:	description of formations encountered	from	to
USPSA Stoneville, MS (mailing address)	SANDY Topsoil SAND + pea gravel	0 15	15 80
WELL LOCATION: sec. 2 T 18 N R 7 E 2 miles N of Stoneville (distance) (direction) (nearest town)			
WELL PURPOSE: IRRIGATION (home, irrigation, municipal, industrial)			
WELL COMPLETION DATA:			
(1) diameter (inches) 2"			
(2) total depth (feet) 80'			
(3) static water level (feet) 15' below top of ground.			
(4) casing PVC 70' (material) (depth) (size) if telescope see back.			
(5) screen 10' 70' (length) (depth to top) 2" PVC (size) (material)			
(6) pump ∅ (HP) (yield gpm) (type power)			
(7) electric log ∅ (yes or no) (organization running log)			
(8) how well bottom plugged Kap			
DRILLERS REMARKS:			


DEPT. OF NATURAL RESOURCES
BUREAU OF LAND & WATER RESOURCES

MAY 14 1982

RECEIVED

If well telescopes please sketch and show depths.

GROUND LEVEL

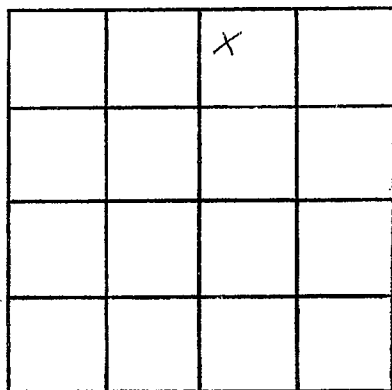

SECTION _____

Please indicate well location X.

ADDITIONAL INFORMATION

If more than one screen,
show locations of each on sketch.