

MISSISSIPPI DEPARTMENT OF NATURAL RESOURCES

Bureau of Land and Water Resources

Southport Mall

P.O. Box 10631

Jackson, Mississippi 39209

WATER WELL DRILLERS LOG

Washington  
E  
2018

4-16 1982 Schultz Drilling Wash. date well completed firm name county well located

LANDOWNER: US DSA  
Stoneville, MS

description of formations encountered	from	to
Sandy Topsoil	0	15
SAND + pea gravel	15	80

(mailing address)

WELL LOCATION:

sec. 2 T-18 N R-7 E  
1 miles N of Stoneville  
(distance) (direction) (nearest town)

WELL PURPOSE: IRRIGATION  
(home, irrigation, municipal, industrial)

WELL COMPLETION DATA:

- (1) diameter (inches) 2"
- (2) total depth (feet) 80'
- (3) static water level (feet) 15' below top of ground.
- (4) casing PVC 70'  
(material) (depth)
- (size) if telescope see back.
- (5) screen 10' 70'  
(length) (depth to top)
- 2" PVC  
(size) (material)
- (6) pump (HP) (yield gpm)
- (type power)
- (7) electric log (yes or no)
- (organization running log)
- (8) how well bottom plugged cap/PVC


DEPT. OF NATURAL RESOURCES  
BUREAU OF LAND & WATER RESOURCES

MAY 14 1982  
RECEIVED

DRILLERS REMARKS:

If well telescopes please sketch and show depths.

GROUND LEVEL

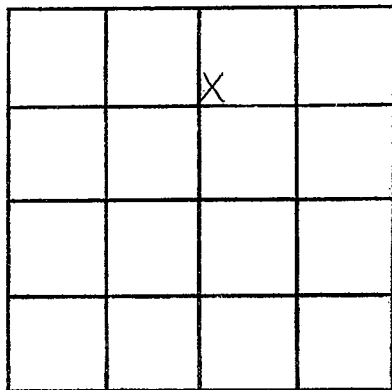

SECTION \_\_\_\_\_

Please indicate well location X.

ADDITIONAL INFORMATION

If more than one screen,  
show locations of each on sketch.